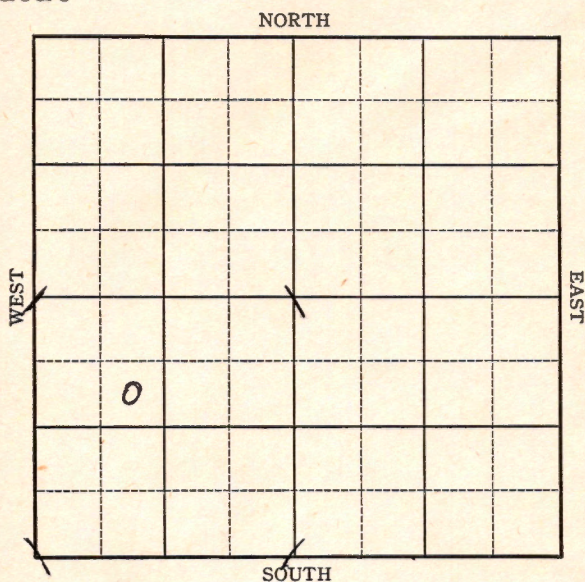


KANSAS

Stafford

Section 6 Township 25 Range 12-WWell No. #1 MatherCompany Plains Exploration  
Wildcat

**KANSAS**

Stafford

Sec. 6 Twp. 25 R. 12W

Well No. #1 Mather Farm

Plains Exploration

Company


Wildcat

990 Ft. from N. Line

Ft. from S. Line

Ft. from E. Line

990 Ft. from W. Line

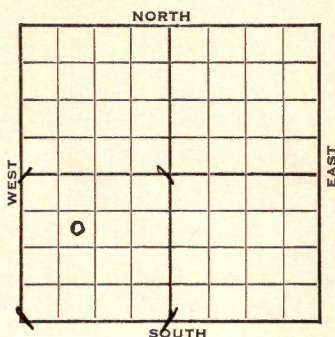

SE NW S<sup>W</sup> Elev. 1923

1942

REPORT

11/10 Atlantic Farmout

11/18 Rotary

11/24 8" @ 272  
Drlg. 2090

12/2 Anhy 730  
Lans 3572  
Drlg. 3660

12/9 Viola 4004  
Simp 4104  
Drlg. 4115

12/16 Arb. 4185  
T.D. 4208'  
No shows.

**ABANDONED**




Stafford

KANSAS

Map No. 47 Sec. 6 Twp. 25 R. 12WWell No. 1 MatherPlains Exploration CompanyFIRST REPORT Contractor

SE NW SW

## SECTION PLAT

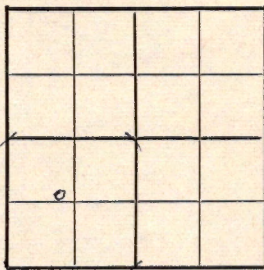990 Ft. from N. Line       Ft. from S. Line       Ft. from E. Line990 Ft. from W. Line

WILDCAT

Location                                 Rig up                                 

Drilling and Remarks:

Atlantic  
farmout

## RECORD

Cased            in.,            ft.Sand                                 Gas                                 Oil                                 Total Depth                                 

## PRODUCTION

1st 24 hrs. Nat.                                 1st 24 hrs. after shot                                 Gas                                  Cu. Ft.Dry Hole                                 Abandoned                                 

Date

NOV 11 1942 19

S. J. LEWIS Scout

**KANSAS**

Stafford

Map No. 47 Sec. 6 Twp. 25 R. 12WWell No. 1 MatherPlains Exploration CompanyABANDONED Contractor

SE NW SW

990 Ft. from N. Line       Ft. from S. Line       Ft. from E. Line990 Ft. from W. Line

## SECTION PLAT

|   |  |  |  |
|---|--|--|--|
|   |  |  |  |
|   |  |  |  |
|   |  |  |  |
| 0 |  |  |  |
|   |  |  |  |

WILDCAT

Location                     Rig up                     

Drilling and Remarks:

*Cer 8 4/85**Nois lower*

## RECORD

Cased            in.,            ft.Sand                     Gas                     Oil                     Total Depth 4208

## PRODUCTION

1st 24 hrs. Nat.                     1st 24 hrs. after shot                     Gas                      Cu. Ft.Dry Hole                     Abandoned                     

Date

DEC 16 1942 19S. J. LEWIS Scout