


Section 10 Township 25 Range 12-W

Well No. #1 Craw

Company Phillips

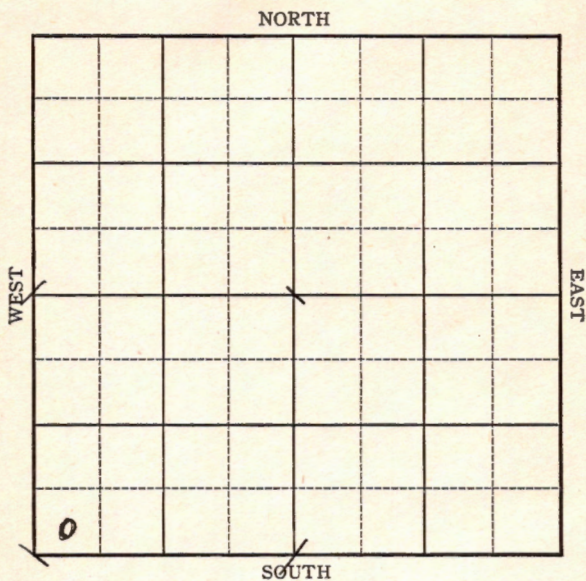

KANSAS

Stafford

Sec. 10 Twp. 25 R. 12-W

Well No. #1 Craw Farm

Phillips Company


 Ft. from N. Line

330 Ft. from S. Line

 Ft. from E. Line

330 Ft. from W. Line

Wildcat

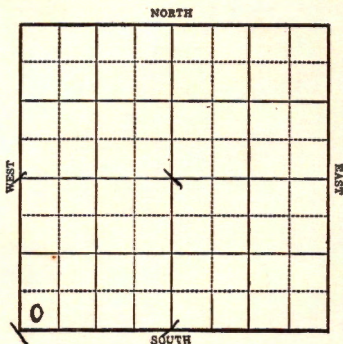

1943

elw. 1870 R E P O R T

7/28

Rotary

8/4

8" @ 484'
Drlg. 890'

8/11

Topeka 3022
Lans 3541
3628' fsg.

8/18

" "

8/25

Lans 3541'
Lost hole
T.D. 3628'

ABANDONED


Stafford

KANSASMap No. 47 Sec. 10 Twp. 25 R. 12WWell No. 1 CrawPhillips CompanyFIRST REPORT Contractor

SW/C

 Ft. from N. Line330 Ft. from S. Line Ft. from E. Line330 Ft. from W. Line

SECTION PLAT

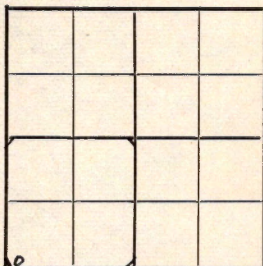

WILDCAT

Location Rig up

Drilling and Remarks:

Rotary

RECORD

Cased in., ft.Sand Gas Oil Total Depth

PRODUCTION

1st 24 hrs. Nat. 1st 24 hrs. after shot Gas Cu. Ft.Dry Hole Abandoned

Date

JUL 28 1943

19

S. J. LEWIS

Scout

Map No. 47 Sec. 10 Twp. 25 R. 12 W

Well No. 1 Crow

Phillips

Company

ABANDONED

Contractor

SW/C

 Ft. from N. Line

330 Ft. from S. Line

 Ft. from E. Line

330 Ft. from W. Line

Wildcat

SECTION PLAT

Location

Rig up

Drilling and Remarks:

Law 3541

Loc X Ar 1/2

RECORD

Cased in., ft.

Sand

Gas

Oil

Total Depth 8625

PRODUCTION

1st 24 hrs. Nat.

1st 24 hrs. after shot

Gas Cu. Ft.

Dry Hole

Abandoned

Date

AUG 25 1943 19

S. J. LEWIS

Scout