


Section 28 Township 25 Range 12-W

Well No. 1 Bonham

Company National Refining

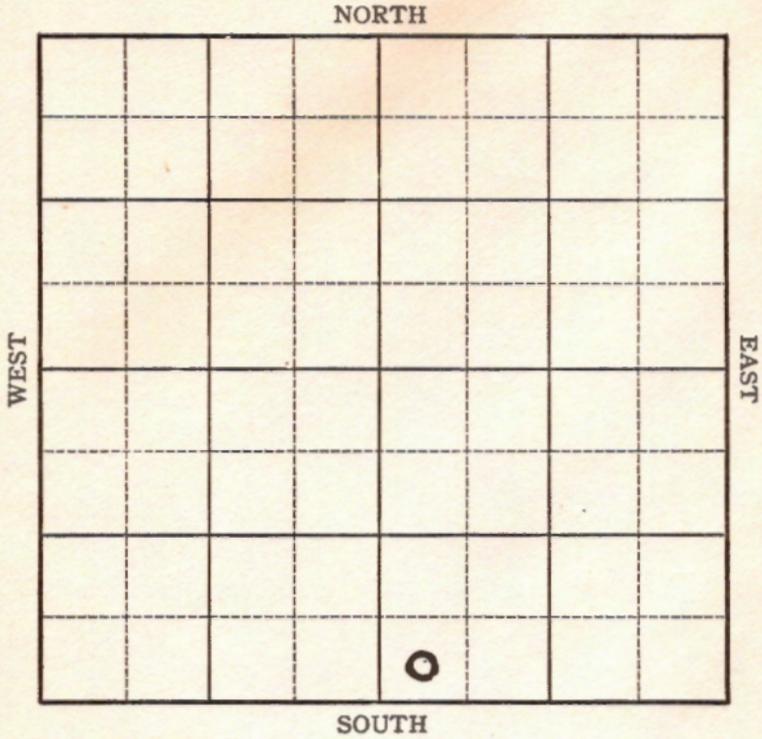

Sec. 28 Twp. 25 R. 12-W

Well No. #1 Bonham Farm


National Refg. Company

         Ft. from N. Line

330 Ft. from S. Line

         Ft. from E. Line

330 Ft. from W. Line

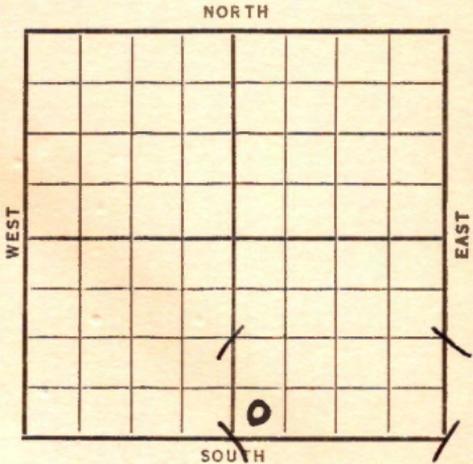

Date	REPORT
1938	
1/26	Cellar.
2/4	12" - 315' WOC
2/11	Anhy 680'. Drlg. 3090'.
2/18	Fort Riley 1990'. Lans. 3589'. T.D. 3605'. 8" @ 3605'. RUST. No shows reported.
2/26	Lans. 3585' (Corrected)
3/4	5 B.W. 3745-55'.
	Drlg. 3885'. No shows.
3/11	Cong. 3966'. Viola 3988'. 7" @ 3934'. H.F.W. 4067-75'. U. R. 7".
3/18	7" @ 4078'. T.D. 4123'.
	U. R. 7".
3/25	Simpl shale 4116'.
	S.G. 4155-59'. H.F.W. 4159-4172'
	Arb. 4200-06' T.D. 6" @ 4150'.
	U. R. No shows.

OVER


1938

- 4/1 1½ bailer fluid in 2 hrs.  
at 4204-10'. T.D. 4212'.  
100 acid. 2½ oil & 5 wtr. in  
12 hrs. Will reacidize.  
Grav. 34.7/98
- 4/8 T.D. 4212'. 1000 acid.
- 4/15 Pump 114 oil & 35 water 12 hrs.  
On potential.
- 4/20 6" @ 4200'.  
Arb. 4200'.  
T.D. 4212'.  
1100 acid.  
Potential 330 bbls.  
Gravity 34.7 at 98.

COMPLETED

Map No. 47 Sec. 28 Twp. 25 R. 12WWell No. 1 BonhamNational Refining Company

Contractor

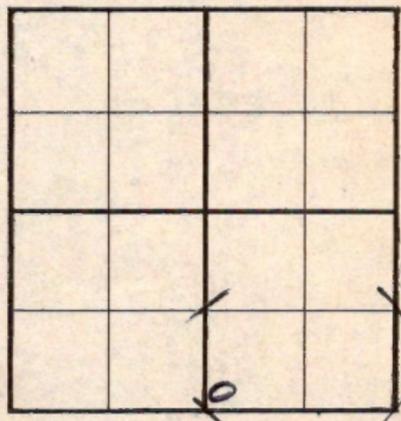**FIRST REPORT**  
SW SE         Ft. from N. Line330 Ft. from S. Line         Ft. from E. Line330 Ft. from W. Line**SECTION PLAT**Location         Rig up         

Drilling and Remarks:

**Cellar****RECORD**Cased          in.,          ft.Sand         Gas         Oil         Total Depth         **PRODUCTION**1st 24 hrs. Nat.         1st 24 hrs. after shot         Gas          Cu. Ft.Dry Hole         Abandoned         

Date

JAN 26 1938 19H. D. Hatfield Scout

Map No. 47 Sec. 28 Twp. 25 R. 12W

Well No. 1 Bonham

National Refining Company

Contractor

**COMPLETED**

**SW SE**

**SECTION PLAT**

		0	

\_\_\_\_\_ Ft. from N. Line

330 Ft. from S. Line

\_\_\_\_\_ Ft. from E. Line

330 Ft. from W. Line

Location \_\_\_\_\_

Rig up \_\_\_\_\_

Drilling and Remarks:

*1100 Acid*

*POT 330*

*GRAV. 34.7 @ 98'*

**RECORD**

Cased 6 in., 4200 ft.

Sand Arb 4200

Gas \_\_\_\_\_

Oil \_\_\_\_\_

Total Depth 4212

**PRODUCTION**

1st 24 hrs. Nat. \_\_\_\_\_

1st 24 hrs. after shot \_\_\_\_\_

Gas \_\_\_\_\_ Cu. Ft.

Dry Hole \_\_\_\_\_

Abandoned \_\_\_\_\_

Date

**APR 20 1938**

19

**H. D. Hatfield**

Scout