

Section 19 Township 25 Range 12WWell No. #1 RussellCompany Edmonson & Harper

NORTH

WEST

0							

EAST

SOUTH

KANAS

Stafford

Sec. 18 Twp. 25 R. 12W

Well No. #1 Russell Farm

Edmonson & Harper Company

Gabbert & Jones Contr Contractor

Leesburg

330

Ft. from N. Line


Ft. from S. Line

Ft. from E. Line

330

Ft. from W. Line

NW NW NW

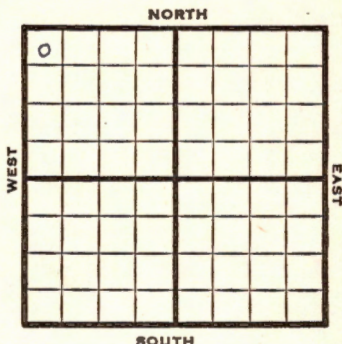

1950

Elev 1908

REPORT

11/1

Spud 10-28-50

8" @ 276

WOC

11/22

8" @ 276

Heeb 3450

Viola 3979

Arb 4182

TD 4200

D&A

Lans 3618

Cong 3974

ABANDONED

County **Stafford** State **Kansas**Sec. **18** (Blk.) **25** (Sur.) **12W** Map No.Operator **Edmonson & Harper**Well No. **1** Farm **Russell**Elev. Location **NW NW NW**

0							

330 Ft. From **N** Line **NW****330** Ft. From **W** Line **Quarter**1st. Report **NOV 1 1950**

Completion

Remarks

Spudding Date **10-28-50**Drlg. Data **Leesburg Pool****8" @ 276 WOC**

County Stafford State KansasSec. 18 (Blk.
Twp.) 25 (Sur.
Rge.) 12W Map No.Operator Edmonson & HarperWell No. 1 Farm RussellElev. 1908 Location NW NW NW

0							

330 Ft. From N Line NW330 Ft. From W Line Quarter1st. ReportCompletion NOV 22 1950Remarks Leesburg PoolGabbert & Jones - Contr.Spudding Date 10-28-50Drlg. Data D & A TD 42008" @ 276 Heeb. 3450 Lans. 3618Viola 3979 Cong. 3974 Arb. 4182TD 4200 D & A

E. TYRA