


Section 20 Township 25 Range 12W

Well No. 1 Bunker

Company Eldorado Ref.

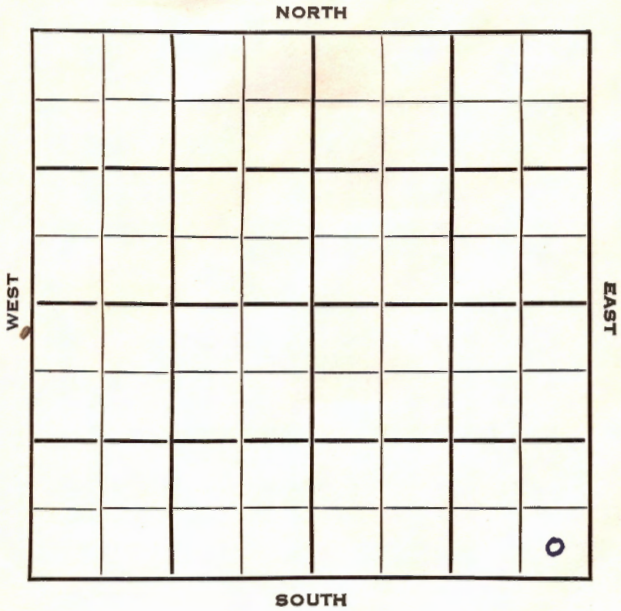


| | | |
|------|------|-------|
| SEC. | TWP. | R. |
| 20 | 25 | 12W ✓ |

WELL NO. **1 Bunker** FARM

COMPANY **ElDorado Ref.**

CONTRACTOR **Sterling Drlg.**

_____ Ft. from N. Line
330 _____ Ft. from S. Line
330 _____ Ft. from E. Line
 _____ Ft. from W. Line

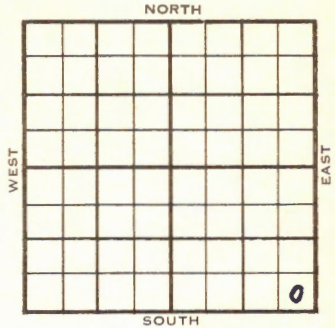

SE SE SE

| | | |
|------|---------------------------|--------|
| 1954 | ELEVATION 1874' | REPORT |
|------|---------------------------|--------|

2/10 Spud 28-8-54
 8" @ 315'

2/17 **Anhy 670'**
 Drlg 3215'

2/24 Spud 2-8-54
 D & A
 TD 4057'
 8" @ 315'

Anhy 670', Heeb 3408', Br. Lime 3575'
Lans 3599', Miss 3969', Kh. 4005'
 DST 3997'-4027' opn 1/2 hr, rec 10' Mud.
Viola 4037'
 TD 4057'
 D & A

ABANDONED

County Stafford State Kansas

Sec. 20 (Blk.) 25 (Sur.) 12W Map No.

Operator Eldorado Ref.

Well No. 1 Farm Bunker

Elev. 1874 Location SE SE SE



330 Ft. From S Line SE

330 Ft. From E Line Quarter

1st. Report

Completion FEB 24 1954

Remarks

Sterling Drlg. - Contr.

Spudding Date 2-8-54

Drlg. Data D & A TD 4057

8" @ 315 Anhy 670 Heeb. 3408

Br. lime 3575 Lans. 3599 Miss. 3969

Kh. 4005 DST 3997-4027 open 1/2 hr.

Rec. 10' mud Viola 4037 TD 4057

D & A

County **Stafford** State **Kansas**

Sec. **20** (Blk.) **25** (Sur.) **12W** Map No.

Operator **Eldorado Ref.**

Well No. **1** Farm **Bunker**

Elev. Location **SE SE SE**

| | | | | | |
|--|--|--|--|--|--|
| | | | | | |
| | | | | | |
330 Ft. From **S** Line **SE**

330 Ft. From **E** Line Quarter

1st. Report **FEB 10 1954**

Completion

Remarks

Sterling Drlg. - Contr.

Spudding Date **2-8-54**

FIRST REPORT

Drlg. Data

8" @ 815