

KANSAS


Stafford

FORM 51 5M 10-41 PETROL

Section 20 Township 25 Range 12-W

Well No. #1 Pierson

Company Broderick & Gordan

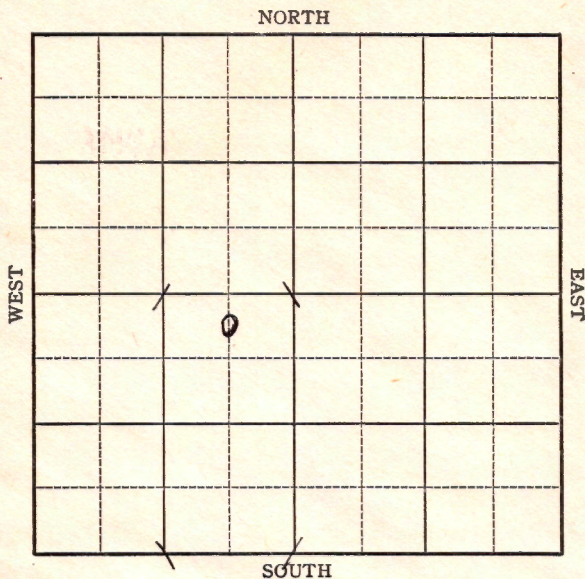

KANSAS

Stafford

Sec. 20 Twp. 25 R. 12-W

Well No. #1 Pierson Farm

Broderick & Gordan Company

Wildcat


330 Ft. from N. Line

Ft. from S. Line

660 Ft. from E. Line

Ft. from W. Line

Elev. 1885

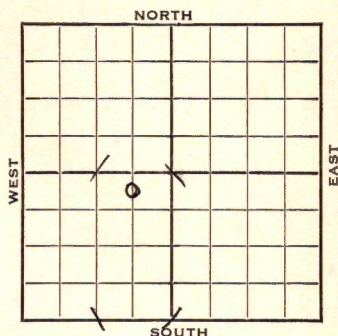

1943

REPORT

- 3/3 Location. Stanolind Farmout
- 3/10 8" Casing set 280 WOC.
- 3/17 **Anhy 715**
Drlg. 2235'
- 3/24 T.D. 2790
1 joint of surface pipe dropped
in hole skid rig.
Drlg. 515'.
- 3/31 Anhy 715 Drlg. 2030'.
- 4/7 Drlg. 3065'
- 4/14 **Lans 3622**
Congl 3990
Drlg. 4015'
- 4/21 **Simp. sd. 4144**
Arb. 4187
Viola 404
T.D. 4230'

ABANDONED

Stafford

KANSAS

Map No. 47 Sec. 20 Twp. 25 R. 12WWell No. 1 PiersonBroderick & Gordon CompanyABANDONED Contractor

C NL NE SW

SECTION PLAT

330 Ft. from N. Line Ft. from S. Line660 Ft. from E. Line Ft. from W. Line

	0		

WILDCAT

Location Rig up

Drilling and Remarks:

Simp Sol 4144
Ac 84189
Vista 404

RECORD

Cased in., ft.Sand Gas Oil Total Depth 4280

PRODUCTION

1st 24 hrs. Nat. 1st 24 hrs. after shot Gas Cu. Ft.Dry Hole Abandoned

Date

APR 21 1943 19

S. J. LEWIS Scout

Stafford

KANSAS

Map No. 47 Sec. 20 Twp. 25 R. 12WWell No. 1 Pierson

Broderick & Gordan


Company

FIRST REPORT

Contractor

C NL NE SW

SECTION PLAT

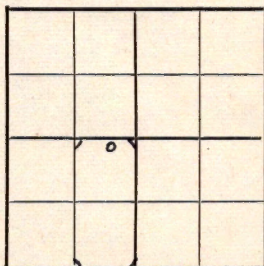330 Ft. from N. Line Ft. from S. Line660 Ft. from E. Line Ft. from W. Line

WILDCA T

Location XXXRig up

Drilling and Remarks:

Stanolind
Farmout

RECORD

Cased in., ft.Sand Gas Oil Total Depth

PRODUCTION

1st 24 hrs. Nat. 1st 24 hrs. after shot Gas Cu. Ft.Dry Hole Abandoned

Date

MAR 3 1943 19

S. J. LEWIS Scout