


Stafford

Section 22 Township 25 Range 12-W

Well No. 1 W. T. Carlile

Company Stanolind

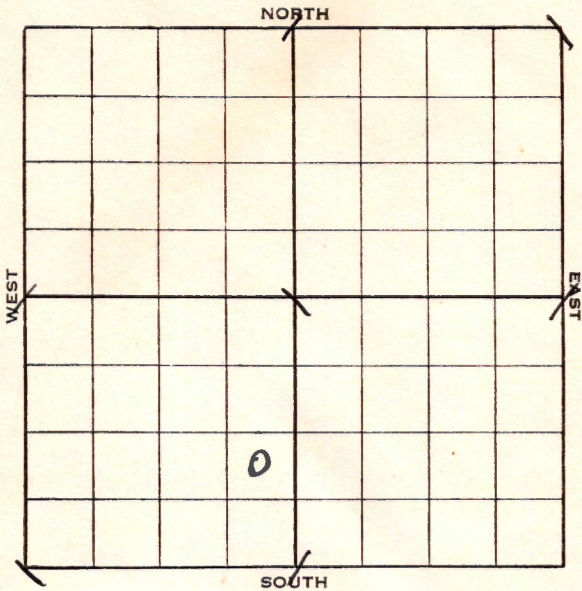

Map No. 47 Sec. 22 Twp. 25 R. 12WWell No. 1 W. T. CarlileStanolind

Company


Contractor

FIRST REPORT

NE SE SW

 Ft. from N. Line990 Ft. from S. Line330 Ft. from E. Line Ft. from W. Line

SECTION PLAT

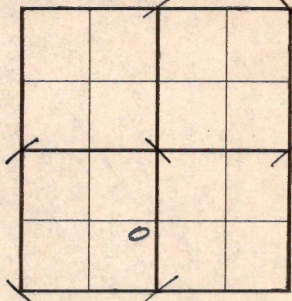Location Rig up

Drilling and Remarks:

10" - 242WOC

RECORD

Cased in., ft.Sand Gas Oil Total Depth

PRODUCTION

1st 24 hrs. Nat. 1st 24 hrs. after shot Gas Cu. Ft.Dry Hole Abandoned

Date

APR 6 - 1938 19H. D. Hatfield Scout

Map No. 47 Sec. 22 Twp. 25 R. 12WWell No. 1 W. T. CarlileStanolind

Company

Contractor

ABANDONED

NE SE SW

SECTION PLAT

	0		

 Ft. from N. Line990 Ft. from S. Line330 Ft. from E. Line Ft. from W. LineLocation Rig up

Drilling and Remarks:

D. V. A.

RECORD

Cased in., ft.Sand A-6 4218Gas Oil Total Depth 4239

PRODUCTION

1st 24 hrs. Nat. 1st 24 hrs. after shot Gas Cu. Ft.Dry Hole Abandoned

Date

MAY 4 - 1938 19 H. D. Hatfield Scout