

KANSAS

Section 32 Township 25 Range 12 W

Well No. # 1 Copehhaver

Company Mercury Drlg.

NORTH

WEST

EAST

0

SOUTH

Stafford

KANSAS
12 W

Sec. 32 Twp. 25 R. 12 W

Well No. # 1 Copenhagen Farm

Mercury Drilling Company

B & R Drlg. Contractor

Wildcat


Ft. from N. Line

330 Ft. from S. Line

330 Ft. from E. Line

Ft. from W. Line

SE SE SW

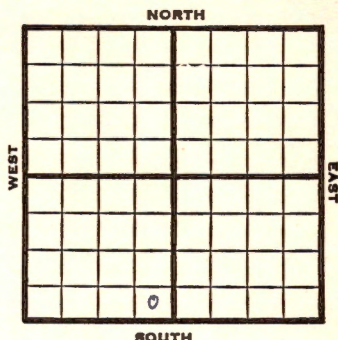

1951

Elev. 1881' REPORT

7/11

Spud 7-7-51

8" @ 228

Anhy 965'

8/15

Drig. 1865'

Spud 7-7-51

D&A TD 4332

8" @ 228' Anhy 965

Heeb. 3450 Tor. 3467

Br lime 3598 Lans. 3622

DST 3658-3705 opn 15 min.

Rec. 760' gas 62' o & gcm

DST 3709-20 opn 1 hr

Rec. 70' socm

DST 3817-24 opn 1/2 hr

Rec. 27' mud & wtr BKC 3912

Viola 4018 Simp 4127

Sand 4193

DST 4187-4200 opn 1/2 hr Rec. 15' mud

DST 4206-20 opn 1 hr. Rec. 90' socm

& wtr Arb. 4282 TD 4332

5" @ 3741 CO to 3674

68/3647-64 B/l go 7 gwph

500 A no inc. 1500 A S/17 bo 37 bw

12 hr. 3000 A S/1 bo 11 bw 2 hr

40/3676-86 2 bo 25 bw 4 hr.

1500 A S/1/2 bo 4 bwph D&A

ABANDONED

8" @ 228 Anhy 965 Drlg. 1865

J. E. TYRA

County Stafford State Kansas
 Sec. 32 (Blk.) 25 (Sur.) 12W Map No. _____
 Operator Mercury-Drlg Phillips Pet.
 Well No. 1 Farm Copenhaver
 Elev. 1881 Location SE SE SW



330 Ft. From S Line SW
330 Ft. From E Line Quarter
 1st. Report _____
 Completion AUG 15 1951
 Remarks Wildcat
B & R Drlg. - Contr.
 Spudding Date 7-7-51

Drlg. Data D & A TD 4332

8" @ 228 Anhy 965 Heeb. 3450

Tor. 3467 Br. line 3598 Lans. 3622

DST 3658-3705 open 15 min. Rec. 760' gas
62' o & gcm DST 3709-20 open 1 hr.

Rec. 70' socm. DST 3817-24 open $\frac{1}{2}$ hr.

Rec. 27' mud & water B KC 3912

Viola 4018 Simp. 4127 sand 4193

DST 4187-4200 open $\frac{1}{2}$ hr. Rec. 15' mud

DST 4206-20 open 1 hr. Rec. 90' socm &
water Arb. 4282 TD 4332 5" @ 3741

CO to 3674 68/ 3647-64 B/ 1 go 7 gwph

500 A no inc. 1500 A S/ 17 bo 37 bw

12 hr. 3000 A S/ 1 bo 11 bw 2 hr.

40/ 3676-86 2 bo 25 bw 4 hr. 1500 A

S/ $\frac{1}{2}$ bo 4 bwph D & A

J. E. TYRA