

Ind  
6/14/85  
8-23-86  
KCC

STATE CORPORATION COMMISSION OF KANSAS  
OIL & GAS CONSERVATION DIVISION

WELL COMPLETION OR RECOMPLETION FORM  
ACO-1 WELL HISTORY

DESCRIPTION OF WELL AND LEASE

Operator: License # 6393  
Name Brougher Oil, Inc.  
Address P.O. Drawer 1367  
Great Bend, Kansas 67530  
City/State/Zip

Purchaser: None

Operator Contact Person Mr. Joe E. Brougher  
Phone 316-793-5610

Contractor: License # 6394  
Name Mohawk Drilling, Inc.

Wellsite Geologist Mr. Brent B. Reinhardt  
Phone 316-793-5610

Designate Type of Completion

- New Well  Re-Entry  Workover
- Oil  SWD  Temp Abd
- Gas  Inj  Delayed Comp.
- Dry  Other (Core, Water Supply etc.)

If OWWO: old well info as follows:

Operator  
Well Name  
Comp. Date Old Total Depth

WELL HISTORY

Drilling Method:

- Mud Rotary  Air Rotary  Cable

5/15/85 5/23/85 5/23/85  
Spud Date Date Reached TD Completion Date  
4380 None  
Total Depth PBT

Amount of Surface Pipe Set and Cemented at 411 feet  
Multiple Stage Cementing Collar Used?  Yes  No  
If yes, show depth set...feet  
If alternate 2 completion, cement circulated from...feet depth to...w/...SX cmt

API NO. 15-185-22,224  
County Stafford  
C.S./2 SE NE Sec. 19 Twp. 25S Rge. 13W  East  West

2970 Ft North from Southeast Corner of Section  
660 Ft West from Southeast Corner of Section  
(Note: Locate well in section plat below)


Lease Name Bunker "A" Well # 5

Field Name Kachelman

Producing Formation None: D&A

Elevation: Ground 1952 KB 1962

Section Plat

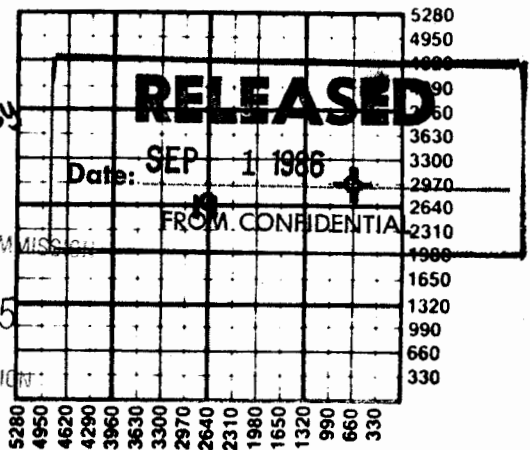

State Geological Survey  
WICHITA BRANCH  
JUN 1 4 1985  
CORPORATION COMMISSION  
Wichita, Kansas

WATER SUPPLY INFORMATION

Disposition of Produced Water:  Disposal  Repressuring  
Docket #

Questions on this portion of the ACO-1 call:  
Water Resources Board (913) 296-3717

Source of Water:  
Division of Water Resources Permit # T 85-491

Groundwater 3960 Ft North from Southeast Corner  
(Well) 1320 Ft West from Southeast Corner of  
Sec 19 Twp 25S Rge 13W  East  West

Surface Water...Ft North from Southeast Corner  
(Stream, pond etc)...Ft West from Southeast Corner  
Sec Twp Rge  East  West

Other (explain) (purchased from city, R.W.D. #)

INSTRUCTIONS: This form shall be completed in duplicate and filed with the Kansas Corporation Commission, 200 Colorado Derby Building, Wichita, Kansas 67202, within 90 days after completion or recompletion of any well. Rule 82-3-130 and 82-3-107 apply.

Information on side two of this form will be held confidential for a period of 12 months if requested in writing and submitted with the form. See rule 82-3-107 for confidentiality in excess of 12 months. One copy of all wireline logs and drillers time log shall be attached with this form. Submit CP-4 form with all plugged wells. Submit CP-111 form with all temporarily abandoned wells.

