


KANSAS

Stafford

Section 24 Township 25 Range 13W

Well No. #1, Russell

Company Nate Appleman

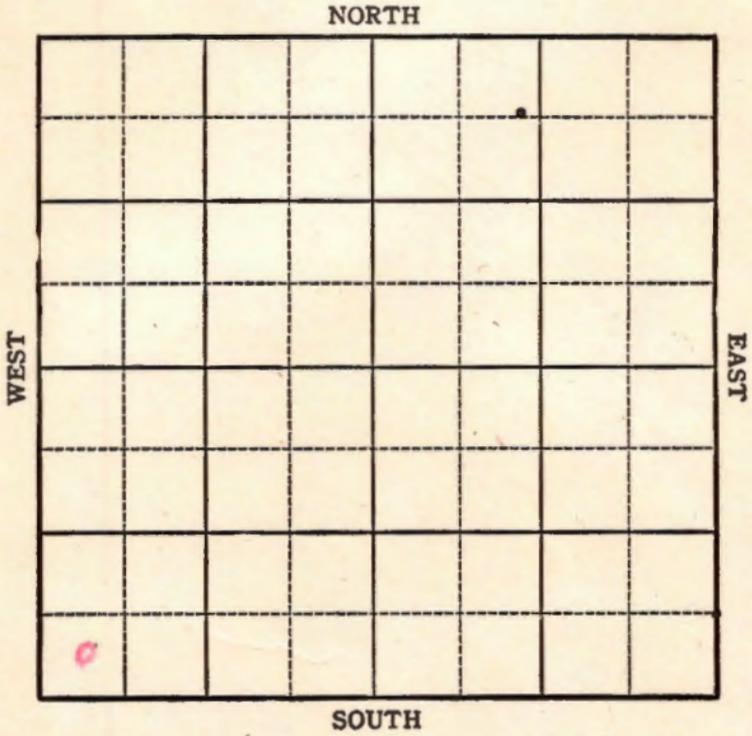

KANSAS

Stafford

Sec. 24 Twp. 25 R. 13W

Well No. #1, Russell Farm

Nate Appleman Company

Wildcat


 Ft. from N. Line

330 Ft. from S. Line

 Ft. from E. Line

330 Ft. from W. Line

Elev. 1916

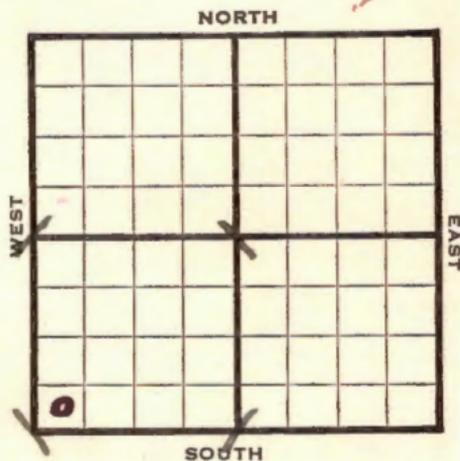

1944

REPORT

5/31	Location		
6/7	"		
6/15	"		
6/21	"		
6/28	"		
7/12	"		
7/19	Surface hole		
7/26	8" @ 320	Anhy 765	Drlg. 2240
8/2	Drlg. 3326		
8/9	Lans 3675		
	Viola 4063		
	Drlg. 4129		
8/16	Lans	3675	
	Arb	4279	
	TD	4309	

ABANDONED

