


Section 29 Township 25 Range 13WWell No. #1 McCandlessCompany Beardmore Drlg.

NORTH

WEST

EAST

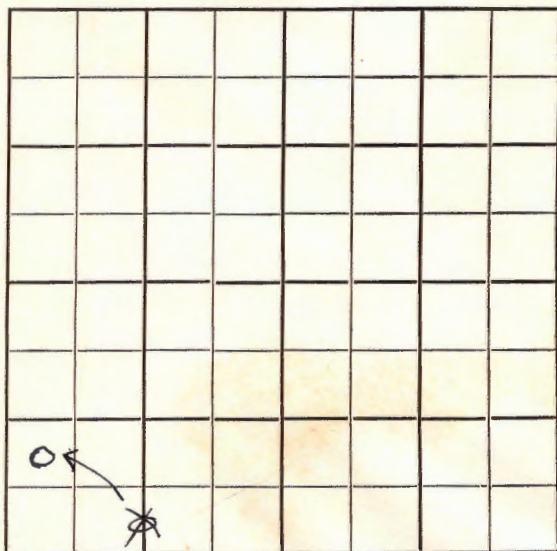

SOUTH

Stafford

KANSAS

Sec. 29 Twp. 25 R. 13 W

1 McCandless

Well No. _____ Farm _____

Beardmore Drlg.

Company _____

Beardmore Drlg.

Contractor _____

Ft. from N. Line

990
330


Ft. from S. Line

Ft. from E. Line

330
1320

Ft. from W. Line

C S L SW
NW SW SW

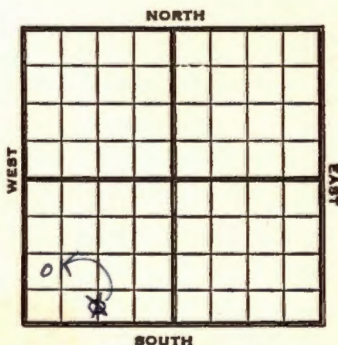

1951

Elev. 1957'

REPORT

6/13

Location

10/17

Spud 7-1-51

Oil well TD 4329

8" @ 1170

KC 3710

DST 3790-3812 open 1 hr.

Rec. 50' mud

DST 3846-60 open 30 min.

Rec. 660' HGCM

Cong. 4096 Miss. 4108

DST 4109-4121 open 1 hr.

Rec. 20' mud

Viola 4160 Simp. 4273

DST 4274-83 open 45 min.

Rec. 7' mud

DST 4278-88 open 1 hr.

Rec. 30' mud

Arb. 4327-29

5" @ 3910 36/ 3852-58 FU 1000'

oil 4 hr. 3000 A P/ 10 BOPH

P/ 40 BOPH Comp. BHB 3000 BOPD

COMPLETED

County **Stafford** State **Kansas**
 Sec. **29** (Blk.) **25** (Sur.) **13W** Map No.
 Operator **Beardmore Drlg.**
 Well No. **1** Farm **McCandless**
 Elev. Location **Cal SW**

FIRST REPORT

330 Ft. From **S** Line **SW**
1320 Ft. From **W** Line **Quarter**

1st. Report **JUN 13 1951**

Completion

Remarks

Beardmore Drlg.- Contr.

Spudding Date

Drlg. Data

Location

J. E. TYRA

Kansas

Map No. _____ Sec. 29 Twp. 25 R. 13WWell No. 1 McCandless

Beardmore Drlg. _____ Company _____

CORRECTION_____
Contractor _____

NW. SW SW

SECTION PLAT

_____ Ft. from N. Line

990 Ft. from S. Line

_____ Ft. from E. Line

330 Ft. from W. Line

Stafford County

Location _____

Rig up _____

Drilling and Remarks:

Reported

C S L SW

RECORD

Cased _____ in., _____ ft.

Sand _____

Gas _____

Oil _____

Total Depth _____

PRODUCTION

1st 24 hrs. Nat. _____

1st 24 hrs. after shot _____

Gas _____ Cu. Ft.


Dry Hole _____

Abandoned _____

Date

JUL 7 1951 19J. E. TYRA

Scout

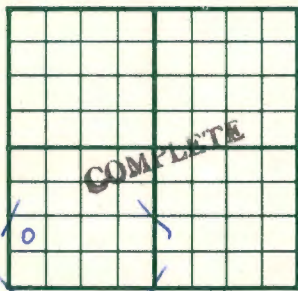County Stafford State KansasSec. 29 (Blk. Twp.) 25 (Sur. Rge.) 13W Map No.Operator Beardmore Drlg.Well No. 1 Farm McCandlessElev. 1957 Location NW SW SW990 Ft. From S Line SW330 Ft. From W Line Quarter1st. ReportCompletion OCT 17 1951RemarksBeardmore Drlg. - Contr.Spudding Date 7-1-51Drlg. Data Oil well TD 43298" @ 1170 KC 3710 DST 3790-3812open 1 hr. Rec. 50' mud DST 3846-60open 30 min. Rec. 660' hgcm Cong. 4096Miss. 4108 DST 4109-4121 open 1 hr.Rec. 20' mud Viola 4160 Simp. 4273DST 4274-83 open 45 min. Rec. 7' mudDST 4278-88 open 1 hr. Rec. 30' mudArb. 4327-29 5" @ 3910 36/ 3852-58FU 1000' oil 4 hr. 3000 A P/ 10 bophP/ 40 boph Comp. BHB 3000 bopd

J. E. TYRA