


Section 29 Township 25 Range 13W
Well No. #2 McCandless
Company Mid-States

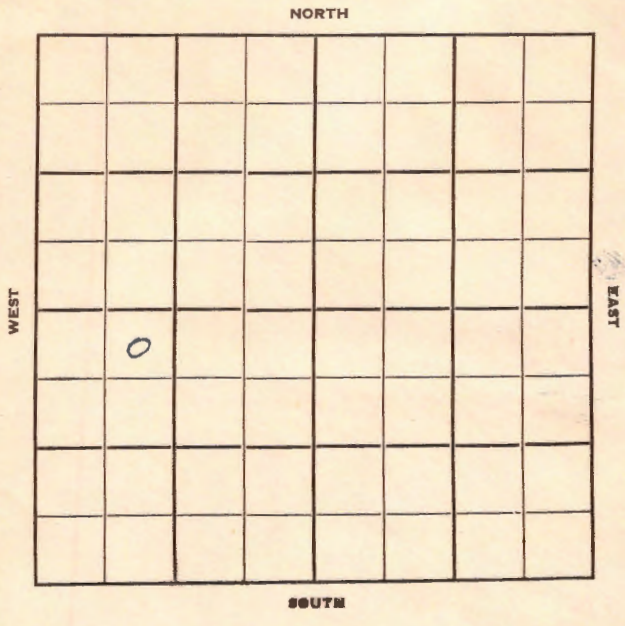

Sec. 29 Twp. 25 R. 13W

Well No. #2 McCandless Farm

Mid-States Company

Contractor

McCandless Pool


330' Ft. from N. Line

Ft. from S. Line

Ft. from E. Line

990' Ft. from W. Line

NE NW SW

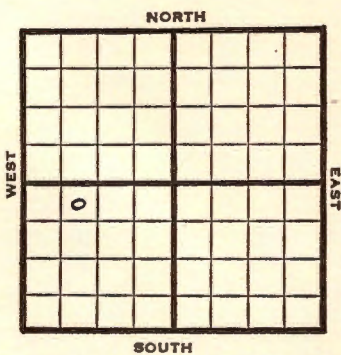

1950

Elev 1953' REPORT

1/25

Spud 1-17-50
Anhy 846'
10" @ 1120'
Drlg. 2220'

3/29

TD 4347'
10" @ 1120'
5" @ 4284'
Viola 4178'
Simp 4292'
Arb. 4326'
D&A
Aband.

ABANDONED

Kansas

Map No. _____ Sec. 29 Twp. 25 R. 13W

Well No. 2 McCandless

Mid-States

Company

Contractor

NE NW SW

SECTION PLAT

330 Ft. from N. Line

_____ Ft. from S. Line

_____ Ft. from E. Line

990 Ft. from W. Line



Stafford County

Location _____

Rig up _____

Drilling and Remarks:

Spud 1-17-50

Anhy 846

10" @ 1120

drlg. 2220

RECORD

Cased _____ in., _____ ft.

Sand _____

Gas _____

Oil _____

Total Depth _____

PRODUCTION

1st 24 hrs. Nat. _____

1st 24 hrs. after shot _____

Gas _____ Cu. Ft.

Dry Hole _____

Abandoned _____

Date

JAN 25 1950 19

E. TYRA Scout

Map No. _____ Sec. 29 Twp. 25 R. 13W

Well No. 2 McCandless

_____ Mid-States _____ Company

_____ Contractor

NE NW SW

E1, 1953

SECTION PLAT

330 Ft. from N. Line

_____ Ft. from S. Line

_____ Ft. from E. Line

990 Ft. from W. Line



Stafford County

Location _____

Rig up _____

Drilling and Remarks:

10" @ 1120

5" @ 4284

Viola 4178

Sims 4292

arb 4326

DVA

RECORD

Cased _____ in., _____ ft.

Sand _____

Gas _____

Oil _____

Total Depth 4347

PRODUCTION

1st 24 hrs. Nat. _____

1st 24 hrs. after shot _____

Gas _____ Cu. Ft.

Dry Hole _____

Abandoned _____

Date

MAR 29 1950

J. E. TYRA

Scout