


Section 26 Township 25 Range 13 W

Well No. # 1 Siebert-Starks

Company Lindas Oil

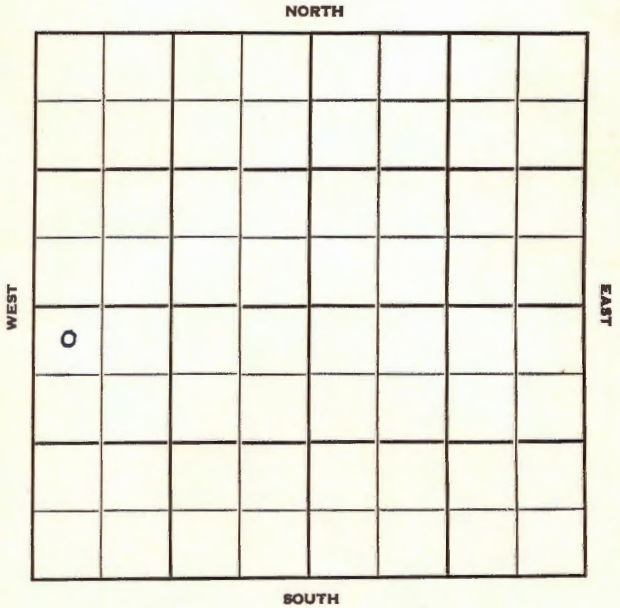

Stafford

KANSAS 13W ✓

Sec. 26 Twp. 25 R. 13W

Well No. #1 Siebert-Starks Farm

Lindas Oil Company

Wildcat


330' Ft. from N. Line

Ft. from S. Line

Ft. from E. Line

330' Ft. from W. Line

NW NW SW

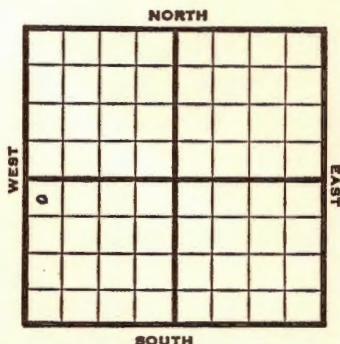

1951

Elev. 1924 REPORT

3/28

Spud 3-25-31
8" @ 436'

4/18

Spud 3-25-51
D&A TD 4375
8" @ 436 Anhy 775
Heeb. 3510 Br Lime 3672
Lans. 3702 Cong. 4047
DST 4047-84 opn 1hr
Rec. 30' so & gcm
Miss 4107 Viola 4180
Lime 4234 Arb. 4335'
TD 4375'
D&A


ABANDONED

County Stafford State Kansas
 Sec. 26 (Blk. 25 (Sur. 13W Map No.

Operator Lindas Oil

Well No. 1 Farm Siebert - Starks

Elev. 1924 Location NW NW SW

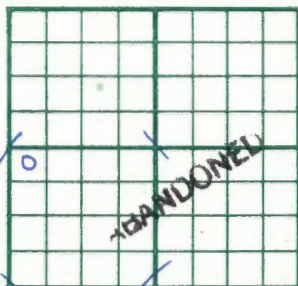

330 Ft. From N Line SW

330 Ft. From W Line Quarter

1st. Report

Completion APR 18 1951

Remarks Wildcat

Spudding Date 3-25-51

Drig. Data D & A TD 4375

8" @ 436 Anhy 775 Heeb. 3510

Br. lime 3672 Lans. 3702 Cong. 4047


DST 4047-84 open 1 hr. Rec. 30' so & gcm

Miss. 4107 Viola 4180 Lime 4234

Arb. 4335 TD 4375

D & A

J. E. TYRA

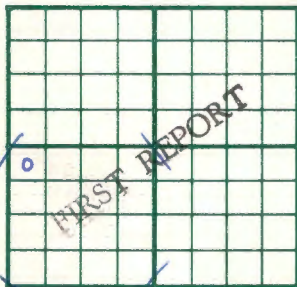County **Stafford** State **Kansas**Sec. **26** (Blk. Twp.) **25** (Sur. Rge.) **13W** Map No.Operator **Lindas Oil**Well No. **1** Farm **Siebert - Starks**Elev. Location **NW NW SW****330** Ft. From **N** Line **SW****330** Ft. From **W** Line Quarter1st. Report **MAR 28 1951**

Completion

Remarks

Spudding Date **3-25-51**Drilg. Data **Wildcat****8" @ 436**

J. E. TYRA