

Stafford


KANSAS

SECTION 29 TOWNSHIP 25 RANGE 13 W

WELL NO. #1 Curtis

COMPANY Strata Drlg. & Jennings

NORTH

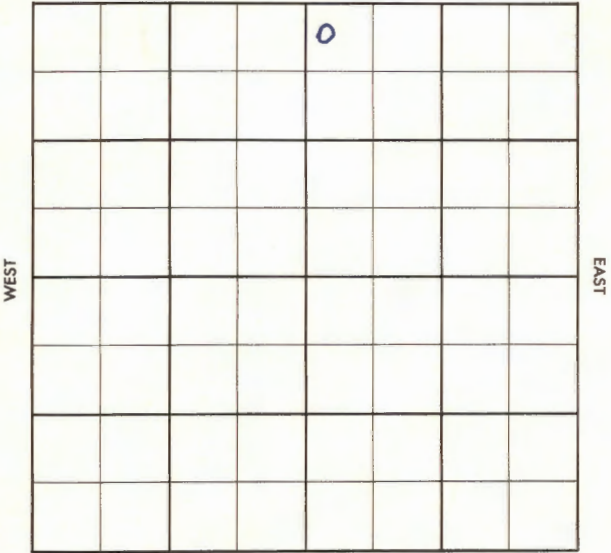

SOUTH

WEST

EAST

Stafford

KANSAS

SEC. 29	TWP. 25	R. 13W
------------	------------	-----------

WELL NO.

#1 Curtis

FARM

COMPANY

Strata Drlg. &amp; Jennings

CONTRACTOR

Co. Tools

McCandless


480 Ft. from N. Line

Ft. from S. Line

Ft. from E. Line

350 Ft. from W. Line

NW NW NE

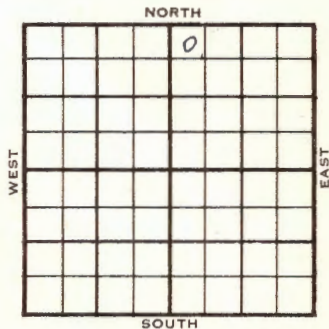

Mid-States FO

1956	ELEVATION 1956' DF	REPORT
------	-----------------------	--------

1-25 Comm. 1-23-56  
8" @ 315/250  
WOC

2-8 DST 4138-95 op 1 hr. rec. 210' GCM  
(spks oil), BHP 175  
RTD 4435, no log.  
D & A  
H. 3562  
BL ~~3728~~ 3728  
L. 3753  
M. 4139  
V. 4243  
S.Sd. 4305  
A. 4409  
TD 4435'

ABANDONED

County Stafford Elev. \_\_\_\_\_  
 Sec. 29 Twp. 25 Rge. 13W  
 Company Strata Drlg. & Jennings  
 Farm Name Curtis No. 1

TOPS	DEPTH	LOG	DATUM	Loc. in Sec.
Anh.				NW NW NE
Tr.				480' NL
H.				350' WL
Tr.				
Dg.				
Bl.				
L.				Geol. _____
K.C.				Contr. _____
B.K.C.				Co. tools
Ce.				
C.				Pool
M.				McCandless
M.				
K.				
Mz.				
Me.				
V.				
S.				
S.				
A.				
R.				
Pe.				
G.				
T.D.				

10

**FIRST REPORT**

JAN 25 '56

Date Comm. 1-23-56 Mid-States farmout  
8" @ 315/250 WOC

\_\_\_\_\_  
 \_\_\_\_\_  
 \_\_\_\_\_  
 \_\_\_\_\_  
 \_\_\_\_\_  
 \_\_\_\_\_

~~24~~

Co.  
 Loc.  
 No.  
 Sec.  
 T.  
 R.

County **Stafford** Elev. **1956 DF**  
 Sec. **29** Twp. **25** Rge. **13W**  
 Company **Strata Drlg. & Jennings**  
 Form Name **Curtis** No. **1**

TOPS	DEPTH	LOG	DATUM	Loc. in Sec.
Ant.				NW NW NE
TP				
H.	x 3562			480' WL
Tr.				350' WL
Dp.				
Bl.	3728			
L.	3753		1797	Pool.
K.C.				Conts.
D.R.C.				Co. tools
Co.				Pool
C.				McCandless
M.	4139		2183	
M.				
K.				
No.				
Mo.				
V.	4243		2287	<div style="border: 1px dashed black; padding: 5px; text-align: center;">                 10                  ABANDONED                  FEB 8 1956             </div>
S.	sd 4305		2249	
R.				
A.	4409		2453	
R.				
Pe.				
A.				
Pa.	4435			

Date Comm. **1-23-56** Mid-States farmout  
 BH @ 315/250 WOO FEB 1 '56 # 3470  
 FEB 8 '56 1-Hb 3562 BL 3728 L39 3753  
 MISS. 4139 DST 4138-95 42 1km  
 MC 210' BEM (SRK oil) BHP 175  
 Yield 4243 SP sd. 4305 RB 4409  
 BTD 4435 no Log

DEA 17