
DX 78-1 Stafford

KANSAS

Section 29 Township 25 Range 13W

Well No. #1 Liss (Leiss)

Company McKnab

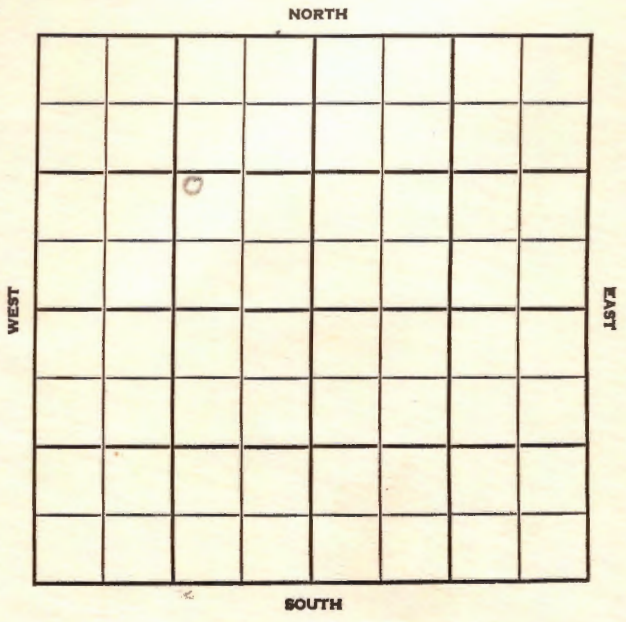

Stafford KANSAS

SEC.	TWP.	R.
29	25	13 W

WELL NO.

1 Liss FARM


COMPANY

McKnab

CONTRACTOR

Co. tools

Semi-WC

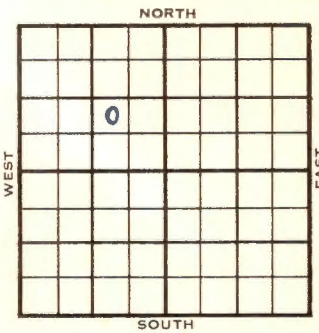

_____ Ft. from N. Line

_____ Ft. from S. Line

_____ Ft. from E. Line

_____ Ft. from W. Line

NW SE NW

1955 ELEVATION 1952' REPORT

6/8 Comm. 6-4-55
8" @ 320/150
Drlg. 1890'

7/20 DST 3851-64, open 1 hr. Rec 275' muddy froggy gco 1070/20" DST 4185-4208 open 1 hr. Rec. 15' mud 0/20" DST 4255-74 open 1½ hr. Rec 1110' free oil 30' ocm 705/30" 5½"@4338 20/4273-78, 500A S/11 boph P/115 bo 22 hr. Comp. 149 bopd.

Tops:	Depth	Datum
H.	3532	1580
Tr.	3550	1598
Dg.	3568	1616
Bl	3686	1734
L.	3712	1760
BKC	3983	2031
M.	4086	2134
K.	4122	2170
V.	4162	2210
S.	4260	2308
A.	4330	2378
TD.	4339	

COMPLETED

DX-78

FORM 513 REV. SUNRAY

County Stafford Elev. 1952

Sec. 29 Twp. 25 Rge. 13W

Company McKnab Drlg.

Farm Name Liss No. 1

TOPS	DEPTH	LOG	DATUM
Anh.			
Tp.			
H.	3532		1580
Tr.	3550		1598
Dg.	3568		1616
Bl.	3686		1734
L.	3712		1760
K.C.			
B.K.C.	3983		2031
Ce.			
C.			
M.	4086		2134
M.			
K.	4122		2170
Mz.			
Mo.			
V.	4162		2210
S.	4260		2308
S.			
A	4330		2378
R.			
Pe.			
G.			
T.D.	4339		

Loc. in Sec. NW SE NW

Geol.

Contr. Co. tools

Pool McCandless

COMPLETE

JUL 20 1955

Date Comm. 6-4-55

8" @ 320/150 DST 3851-64 open 1 hr.
Rec. 275' muddy froggy gco 1070/20"
DST 4185-4208 open 1 hr. Rec. 15' mud
0/20" DST 4255-74 open 1½ hr. Rec.
1110' free oil 30' ocm 705/30"
5½" @ 4338 20/ 4273-78 500 A
S/ 11 boph P/ 115 bo 22 hr.
Comp. 149 bopd

Co. Lse. No. Sec. T. R.

FORM 513 REV. SUNRAY

County Stafford ✓ Elev.

Sec. 29 Twp. 25 Rge. 13W

Company McKnab

Farm Name Liss No. 1

TOPS	DEPTH	LOG	DATUM
Anh.			
Tp.			
H.			
Tr.			
Dg.			
Bl.			
L.			
K.C.			
B.K.C.			
Ce.			
C.			
M.			
M.			
K.			
Mz.			
Mo.			
V.			
S.			
S.			
A			
R.			
P€.			
G.			
T.D.			

Loc. in Sec. NW SE NW

Geol.

Contr. Co. tools

Pool Semi WC

JUN 8 '55

FIRST REPORT

Date Comm. 6-4-55

8" @ 320/150 drlg. 1890

K-26

Co. Lse. No. Sec. T. R.