

KANSAS

Stafford

Section 29 Township 25 Range 13WWell No. 1 McCandles sCompany Sun Oil

McCandless

NORTH

WEST

EAST

0							

SOUTH

KANSAS

Stafford

Sec. 29 Twp. 25 R. 13W ✓

Well No. #1 McCandless Farm

Sun Oil

McCandless Pool **O. W. P. B.** Company

 Ft. from N. Line


330'

 Ft. from S. Line

 Ft. from E. Line

330' Ft. from W. Line

SW/C

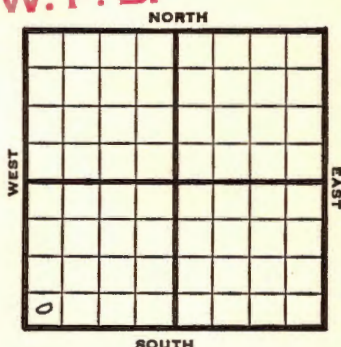

1949

Elev. 1960' REPORT

5/11

Location

5/18

"

5/25

"

6/1

8" @ 834'

6/7

Drlg 2072'

6/15

Drlg. 3320'

6/21

Lansing 3683'

Miss 4085'

Viola 4147'

Drlg. 4205'

6/28

Correction: Lansing 3720'

Miss 4100' Viola 4205'

Simpson 4276' Arbuckle 4320'

TD 4336'

5" @ 3993'

7/6

"

7/12

"

7/20

"

7/27

Arb 4320'

5" @ 3995'

TD 4336'

ABANDONED

O. W. P. B.

1950

11/15

~~Lans. 3688' Simp 4269' QTD 4295'~~

~~SP 3900 84/3840-54 1 BOPN 500 A~~

~~F/35 BO 4 hr S/6 BOPH POP~~

Kansas


Map No. _____ Sec. 29 Twp. 25 R. 13WWell No. 1 McCandlessSun Oil

Company

FIRST REPORT Contractor

SW/C

SECTION PLAT

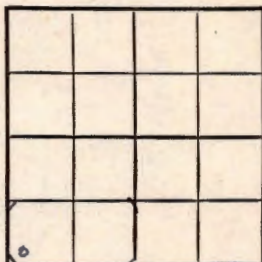

_____ Ft. from N. Line

330 Ft. from S. Line

_____ Ft. from E. Line

330 Ft. from W. Line

Stafford County

Location X

Rig up _____

Drilling and Remarks:

RECORD

Cased _____ in., _____ ft.

Sand _____

Gas _____

Oil _____

Total Depth _____

PRODUCTION

1st 24 hrs. Nat. _____

1st 24 hrs. after shot _____

Gas _____ Cu. Ft.

Dry Hole _____

Abandoned _____

Date

MAY 11 1949

19

S. J. LEWIS

Scout

Kansas

McCandless Pool

Map No. K83 Sec. 29 Twp. 25 R. 13WWell No. 1 McCandless

Sun Oil

Company

ABANDONED

Contractor

SW/C

SECTION PLAT

 Ft. from N. Line330 Ft. from S. Line Ft. from E. Line330 Ft. from W. Line

Stafford County

Location Rig up

Drilling and Remarks:

OK 4820
5" @ 3985

RECORD

Cased in., ft.Sand Gas Oil Total Depth 4836

PRODUCTION

1st 24 hrs. Nat. 1st 24 hrs. after shot Gas Cu. Ft.Dry Hole Abandoned

Date

JUL 27 1949 19

S. J. LEWIS

Scout