

Section 30 Township 25 Range 13-W

Well No. #3 Goodman

Company C S O  
McCandles Pool

NORTH

WEST

EAST

|  |  |  |  |  |  |  |  |
|--|--|--|--|--|--|--|--|
|  |  |  |  |  |  |  |  |
|  |  |  |  |  |  |  |  |
SOUTH

Sec. 30 Twp. 25 R. 13W

Well No. #3 Goodman Farm

C S O

Company

Rine Drlg.

Contractor

McCandless Pool


Ft. from N. Line

330' Ft. from S. Line

990' Ft. from E. Line

Ft. from W. Line

SW SE SW

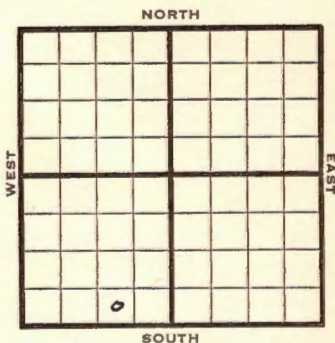

1949

**Elev 1971'**

REPORT

10/26

8" @ 859'

Drlg. 3020'

11/1

**Lansing 3724'**

**Viola 4221'**

Drlg 4255'

11/9

TD 4306'

**Miss 4107'**

**Viola 4221'**

**Simpson 4273'**

Aband.

**ABANDONED**

Map No. \_\_\_\_\_ Sec. 30 Twp. 25 R. 13W

Well No. 3 Goodman

C S O

Company \_\_\_\_\_

Rine Drlg.

Contractor \_\_\_\_\_

SW SE SW

**FIRST REPORT  
SECTION PLAT**

|  |  |  |  |
|--|--|--|--|
|  |  |  |  |
|  |  |  |  |
|  |  |  |  |
|  |  |  |  |

\_\_\_\_\_ Ft. from N. Line

330 Ft. from S. Line

990 Ft. from E. Line

\_\_\_\_\_ Ft. from W. Line

Stafford County

Location \_\_\_\_\_

Rig up \_\_\_\_\_

Drilling and Remarks:

8" @ 859

drlg. 3020

**RECORD**

Cased \_\_\_\_\_ in., \_\_\_\_\_ ft.

Sand \_\_\_\_\_

Gas \_\_\_\_\_

Oil \_\_\_\_\_

Total Depth \_\_\_\_\_

**PRODUCTION**

1st 24 hrs. Nat. \_\_\_\_\_

1st 24 hrs. after shot \_\_\_\_\_

Gas \_\_\_\_\_ Cu. Ft.

Dry Hole \_\_\_\_\_

Abandoned \_\_\_\_\_

Date

OCT 26 1949 19

S. J. LEWIS Scout

Kansas

McCandles Pool

Map No. \_\_\_\_\_ Sec. 30 Twp. 2 5 R. 13WWell No. 3 Goodman

C S O

Company

ABANDONED

Contractor

SW SE SW

*E 4/1971*  
SECTION PLAT

\_\_\_\_\_ Ft. from N. Line

330 Ft. from S. Line990 Ft. from E. Line

\_\_\_\_\_ Ft. from W. Line



Stafford County

Location \_\_\_\_\_

Rig up \_\_\_\_\_

Drilling and Remarks:


## RECORD

Cased \_\_\_\_\_ in., \_\_\_\_\_ ft.

Sand \_\_\_\_\_

Gas \_\_\_\_\_

Oil \_\_\_\_\_

Total Depth 4346

## PRODUCTION

1st 24 hrs. Nat. \_\_\_\_\_

1st 24 hrs. after shot \_\_\_\_\_

Gas 1000 Cu. Ft.

Dry Hole \_\_\_\_\_

Abandoned \_\_\_\_\_

Date

NOV 9 1949

19

S. J. LEWIS

Scout