


Section 30 Township 25 Range 13WWell No. #4 McCandlessCompany Atlantic

NORTH

WEST

EAST

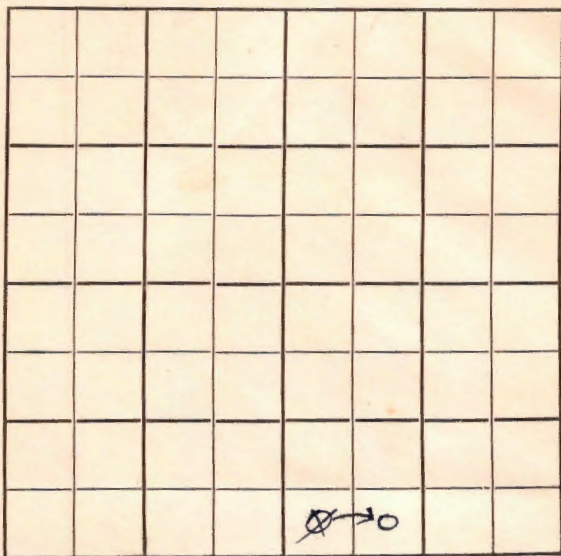

SOUTH

Stafford

KANSAS

Sec. 30 Twp. 25 R. 13W

Well No. #4 McCandless Farm

Atlantic Company

Contractor

McCandless Pool

 Ft. from N. Line


330' Ft. from S. Line

 Ft. from E. Line

330' Ft. from W. Line

~~SW SW SE~~

SE SW SE

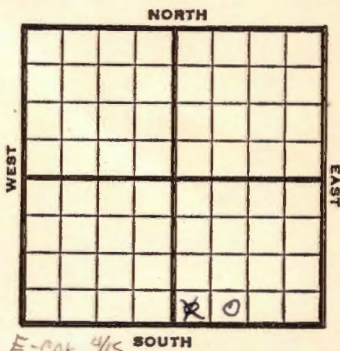

1950

1962 LVS REPORT

1/25

Spud 1-23-50
Drilg. 565'

4/12

TD 4317'
8"@ 1232'
Heeb 3527'
Lans 3709'
Miss 4122'
Viola 4189'
Simp 4268'
Arb. 4312'
5"@ 4314'
218 BOPD
Comp

COMPLETED

Kansas

McCandless

Map No. _____ Sec. 30 Twp. 25 R. 13WWell No. 4 McCandlessAtlantic
CORRECTION _____ Company

Contractor

SE SW SE

El. 1962

SECTION PLAT

_____ Ft. from N. Line

330 Ft. from S. Line

_____ Ft. from E. Line

990 Ft. from W. Line

Stafford County

Location _____

Rig up _____

Drilling and Remarks:

Reported

SW SW SE

RECORD

Cased _____ in., _____ ft.

Sand _____

Gas _____

Oil _____

Total Depth _____

PRODUCTION

1st 24 hrs. Nat. _____

1st 24 hrs. after shot _____

Gas _____ Cu. Ft.

Dry Hole _____

Abandoned _____

Date

FEB 15 1930 19

J. E. TYRA

Scout

Map No. _____ Sec. 30 Twp. 25 R. 13WWell No. 4 McCandlessAtlantic

Company

Contractor

SW SW SE

SECTION PLAT

Ft. from N. Line

330

Ft. from S. Line

Ft. from E. Line

330

Ft. from W. Line

Stafford County

RECORD

Location _____

Cased _____ in., _____ ft.

Rig up _____

Sand _____

Drilling and Remarks:

Gas _____

Spud 1-23-50

Oil _____

drlg. 565

Total Depth _____

PRODUCTION

1st 24 hrs. Nat. _____

1st 24 hrs. after shot _____

Gas _____ Cu. Ft.

Dry Hole _____

Abandoned _____

Date

JAN 25 1950J. E. TYRA

Scout

Kansas

McCandless Pool


Map No. _____ Sec. 30 Twp. 25 R. 13WWell No. 4 McCandless

_____ Atlantic _____ Company

_____ Contractor

SE SW SE

SECTION PLAT

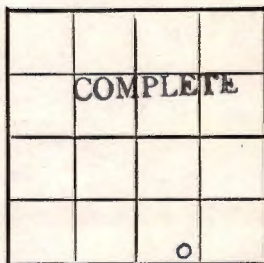

_____ Ft. from N. Line

330 Ft. from S. Line

_____ Ft. from E. Line

490
330 Ft. from W. Line

Stafford County

Location _____

Rig up _____

Drilling and Remarks:

8" @ 1232

Hub 3527

Lans 3709

Miss 4122

Viola 4189

Simp 4268

Ant 4312

Date

5" @ 4314

218 BOPD

RECORD

Cased _____ in., _____ ft.

Sand _____

Gas _____

Oil _____

Total Depth 4317

PRODUCTION

1st 24 hrs. Nat. _____

1st 24 hrs. after shot _____

Gas _____ Cu. Ft.

Dry Hole _____

Abandoned _____

APR 12 1950

19

J. E. TYRA Scout