

DX 78-1

Stafford

KANSAS

Section 30 Township 25 Range 13W

Well No. 1 McCandless

Company McKnab Drlg.

NORTH

|  |  |  |  |  |   |  |  |  |  |
|--|--|--|--|--|---|--|--|--|--|
|  |  |  |  |  | 0 |  |  |  |  |
|  |  |  |  |  |   |  |  |  |  |
|  |  |  |  |  |   |  |  |  |  |
SOUTH

WEST

EAST


|      |      |     |
|------|------|-----|
| SEC. | TWP. | R.  |
| 30   | 25   | 13W |

WELL NO. **1 McCandless** FARM

COMPANY **McKnab Drlg.**

CONTRACTOR **Co. Tools**  
**Semi Wildcat**

\_\_\_\_\_ Ft. from N. Line  
 \_\_\_\_\_ Ft. from S. Line  
 \_\_\_\_\_ Ft. from E. Line  
 \_\_\_\_\_ Ft. from W. Line

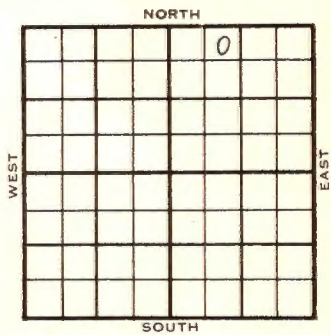

NE NW NE

| 1955 | ELEVATION | REPORT |
|------|-----------|--------|
|------|-----------|--------|

1956'

6/22 Comm 6-22-55

9/7 Comm 6-23-55

- H 3526
- BL 3682
- L 3708
- BKC 2978
- M 4080
- K 4105
- V 4159
- S sh 4281
- S sd 4289
- A 4345
- TD 4365

8 5/8" @ 323 DST 3844-80 open 1 hr gas in 7 min. Rec 640' clean oil 360' froggy oil 1160/20"

DST 3884-3905 open 1 hr Rec 25' mud,  
 DST 4168-4203 open 1 hr Rec 75' socm 385/20"

DST 4280-97 open 1 1/2 hr Rec 3500' gas 200' oil, 60' ho & GCM, 550/20"

5 1/2" @ 4350 CO 30/4291-96 re perf 30/4291-96 B/2 1/2 goph 500 A

S/1 3/4 bfph 99% wt5. 24/4300-04 frac perg 4291-96 S/19 boph

Comp 164 bopd

**COMPLETED**

County Stafford Elev. \_\_\_\_\_  
 Sec. 30 Twp. 25 Rge. 13W  
 Company McKnab Drlg.  
 Farm Name McCandless No. 1

Co.

| TOPS   | DEPTH | LOG | DATUM |
|--------|-------|-----|-------|
| Anh.   |       |     |       |
| Tp.    |       |     |       |
| H.     |       |     |       |
| Tr.    |       |     |       |
| Dg.    |       |     |       |
| Bl.    |       |     |       |
| L.     |       |     |       |
| K.C.   |       |     |       |
| B.K.C. |       |     |       |
| Ce.    |       |     |       |
| C.     |       |     |       |
| M.     |       |     |       |
| M.     |       |     |       |
| K.     |       |     |       |
| Mz.    |       |     |       |
| Mo.    |       |     |       |
| V.     |       |     |       |
| S.     |       |     |       |
| S.     |       |     |       |
| A.     |       |     |       |
| R.     |       |     |       |
| Pc.    |       |     |       |
| G.     |       |     |       |
| TD.    |       |     |       |

Loc. in Sec. NE NW NE

Geol. \_\_\_\_\_

Contr. \_\_\_\_\_

Co. tools

Pool \_\_\_\_\_

Semi Wildcat

|              |  |   |
|--------------|--|---|
|              |  | 0 |
| FIRST REPORT |  |   |
| JUN 22 55    |  |   |

Lse.

No.

Sec.

T.

R.

Date Comm. 6-22-55

*K-26*

County Stafford Elev. 1956  
 Sec. 30 Twp. 25 Rge. 13W  
 Company McKnab Drlg.  
 Farm Name McCandless No. 1

| TOPS     | DEPTH | LOG | DATUM | Loc. in Sec.  |  |  |   |          |  |  |  |  |  |
|----------|-------|-----|-------|---|--|--|---|----------|--|--|--|--|--|
| Anh.     |       |     |       | NE NW NE  |  |  |   |          |  |  |  |  |  |
| Tr.      |       |     |       |   |  |  |   |          |  |  |  |  |  |
| H.       | 3526  |     | 1570  |   |  |  |   |          |  |  |  |  |  |
| Dg.      |       |     |       |   |  |  |   |          |  |  |  |  |  |
| B.L.     | 3682  |     | 1726  |   |  |  |   |          |  |  |  |  |  |
| L.       | 3708  |     | 1752  | Geol.   |  |  |   |          |  |  |  |  |  |
| K.C.     |       |     |       | Contr.  |  |  |   |          |  |  |  |  |  |
| B.K.C.   | 3978  |     | 2022  | Co. tools   |  |  |   |          |  |  |  |  |  |
| Ce.      |       |     |       | Pool  |  |  |   |          |  |  |  |  |  |
| C.       |       |     |       | McCandless  |  |  |   |          |  |  |  |  |  |
| M.       | 4080  |     | 2124  | <table border="1"> <tr> <td></td> <td></td> <td>0</td> </tr> <tr> <td colspan="3" style="text-align: center;">COMPLETE</td> </tr> <tr> <td></td> <td></td> <td></td> </tr> </table> |  |  | 0 | COMPLETE |  |  |  |  |  |
|          |       | 0   |       |   |  |  |   |          |  |  |  |  |  |
| COMPLETE |       |     |       |   |  |  |   |          |  |  |  |  |  |
|          |       |     |       |   |  |  |   |          |  |  |  |  |  |
| M.       |       |     |       |   |  |  |   |          |  |  |  |  |  |
| K.       | 4105  |     | 2149  |   |  |  |   |          |  |  |  |  |  |
| Mz.      |       |     |       |   |  |  |   |          |  |  |  |  |  |
| Me.      |       |     |       |   |  |  |   |          |  |  |  |  |  |
| V.       | 4159  |     | 2203  |   |  |  |   |          |  |  |  |  |  |
| S.       | 4281  |     | 2325  |   |  |  |   |          |  |  |  |  |  |
| S.       | 4289  |     | 2333  |   |  |  |   |          |  |  |  |  |  |
| A.       | 4345  |     | 2389  |   |  |  |   |          |  |  |  |  |  |
| R.       |       |     |       |   |  |  |   |          |  |  |  |  |  |
| Pe.      |       |     |       |   |  |  |   |          |  |  |  |  |  |
| G.       |       |     |       |   |  |  |   |          |  |  |  |  |  |
| T.D.     | 4365  |     |       |   |  |  |   |          |  |  |  |  |  |

Date Comm. 6-23-55 SEP 7 1955

8 5/8" @ 323 DST 3844-80 open 1 hr.

gas in 7 min. Rec. 640' clean oil

360' froggy oil 1160/20" DST 3884-3905

open 1 hr. Rec. 25' mud DST 4168-4203

open 1 hr. Rec. 75' socm 385/20"

DST 4280-97 open 1 1/2 hr. Rec. 3500' gas

200' oil. 60' ho & gem 550/20"

5 1/2" @ 4350 CO 30/4291-96 reperf.

30/4291-96 B/ 2 1/2 goph 500 A

**OVER**

S/ 1 3/4 bfph 99% wtr. 2 1/4/ 4300-04

frac perg. 4291-96 S/ 19bopd

Comp. 16 1/4 bopd

Scout Cards *W. M. J.*  
Land Small Map  
Land Wall Map  
Tracings  
France Map  
Pierce Map  
Misc.

SEP 15 1955