

KANSAS


FORM 51 5M BRIX

Stafford

Section 30 Township 25 Range 13W

Well No. #2 McCandless

Company Atlantic

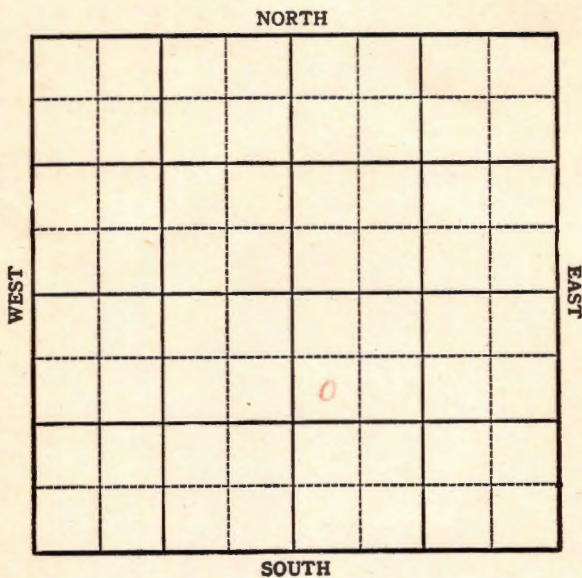

KANSAS

Stafford

Sec. 30 Twp. 25 R. 13W

Well No. #2 McCandless Farm

Atlantic Company

NORTH

McCandless

990' Ft. from N. Line

Ft. from S. Line

Ft. from E. Line

330'

Ft. from W. Line

WEST

EAST

SOUTH

elev. 1959

1944

REPORT

6/21	Rotary
6/28	Anhy 803
	8" @ 826
	1839 SD
7/12	Drlg. 3655
7/19	Lans 3715
	Drlg 4264
7/26	Viola 4222
	Simp Sd 4299
	TD 4335

ABANDONED

KANSAS

FORM NO. 200 BKS. 1 44 PETROL

Pool Name McCandlessMap No. 83 Sec. 30 Twp. 25 R. 13WWell No. 2 McCandlessAtlantic

Company

FIRST REPORT

Contractor

SW NW SE

SECTION PLAT

990

Ft. from N. Line

Ft. from S. Line

Ft. from E. Line

330

Ft. from W. Line

Stafford County

Location

Rig up

Drilling and Remarks:

Rotary

RECORD

Cased _____ in., _____ ft.

Sand _____

Gas _____

Oil _____

Total Depth _____

PRODUCTION

1st 24 hrs. Nat. _____

1st 24 hrs. after shot _____

Gas _____ Cu. Ft.

Dry Hole _____

Abandoned _____

Date

JUN 2 1 1944

19

S. J. LEWIS Scout

Pool Name McCandlessMap No. 88 **KANSAS** Sec. 30 Twp. 25 R. 13WWell No. 2 McCandlessAtlantic

Company

ABANDONED

Contractor

SW NW SE

SECTION PLAT

990 Ft. from N. Line Ft. from S. Line Ft. from E. Line330 Ft. from W. Line

Stafford County

Location Rig up

Drilling and Remarks:

*Viola 4222**Bony Sol 4299*

RECORD

Cased in., ft.Sand Gas Oil Total Depth 4395

PRODUCTION

1st 24 hrs. Nat. 1st 24 hrs. after shot Gas Cu. Ft.Dry Hole Abandoned

Date

JUL 26 1944 19S. J. LEWIS

Scout