

O. W. P. B. KANSAS

Section 30 Township 25 Range 13W

Well No. 3 McCandless

Company Atlantic

McCandless
NORTH

WEST

EAST

SOUTH

0

Sec. 30 Twp. 25 R. 13-W ✓

Well No. #3 McCandless Farm

Atlantic Company


McCandless Pool

 Ft. from N. Line

990 Ft. from S. Line

330 Ft. from E. Line

 Ft. from W. Line

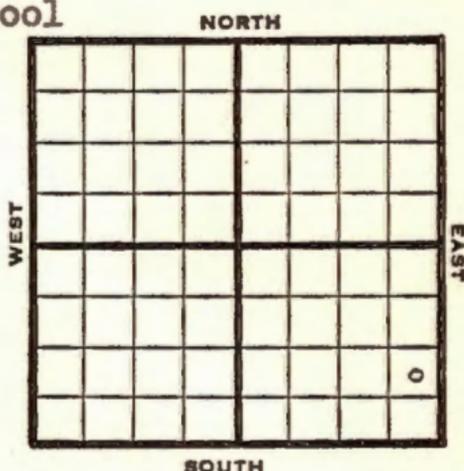

NE SE SE

1949

Elev. 1958' REPORT

1/26	Location
2/2	RUR
2/9	8" @ 851'
	Drlg. 955'
2/16	Drlg. 3160'
2/23	Lansing 3701'
	Drlg. 4005'
3/2	Simpson 4238'
	Arbuckle 4285'
3/8	Drlg. 4310'
	TD 4310
	5" @ 4308'
3/16	"
3/23	15 shots 4248-60
	2000 acid
	Swb 20 bbls Oil PH
3/30	Simp. 4238'
	Arb 4285'
	5" @ 4308'
	Perf Simp
	2000 acid
	Bottom Pot. 1342 oil
	Gr. 39°
	TD 4310'

COMPLETED

OVER

1952

O. W. P. B.

4/30

Lans. 3684 Simp. sd 4248- prod.
Arb. 4285 still prod from Simp
on pump TD 4310 5" @ 4308
16/ 3850-54 24/ 3834-40 set pkr.
4226 8000 A F 288 Bo plus
8/10 of 1% wtr. 23 hrs. 203 Bopd
from Lans. Comp.

FIRST REPORT

✓
COMPLETED

O. W. P. B.

Map No. _____ Sec. 30 Twp. 25 R. 13WWell No. 3 McCandlessAtlantic

Company

FIRST REPORT

Contractor

NE SE SE

SECTION PLAT

_____ Ft. from N. Line

990 Ft. from S. Line330 Ft. from E. Line

_____ Ft. from W. Line

			o

Stafford County

Location X

Rig up _____

Drilling and Remarks:

RECORD

Cased _____ in., _____ ft.

Sand _____

Gas _____

Oil _____

Total Depth _____

PRODUCTION

1st 24 hrs. Nat. _____

1st 24 hrs. after shot _____

Gas _____ Cu. Ft.

Dry Hole _____

Abandoned _____

Date

JAN 26 1949 19S. J. LEWIS Scout

Kansas

Map No. 82 Sec. 30 Twp. 25 R. 13W

Well No. 3 McCandless

Atlantic Company

COMPLETE

Contractor

NE SE SE

E. 1958
SECTION PLAT

_____ Ft. from N. Line

990 Ft. from S. Line

330 Ft. from E. Line

_____ Ft. from W. Line

			0

Stafford County

Location _____

Rig up _____

Drilling and Remarks:

Sing 4285
Ca 4285
5" casing
Prof. Sing
2000 cu ft
Born 12 13 42 oil
99 324

RECORD

Cased _____ in., _____ ft.

Sand _____

Gas _____

Oil _____

Total Depth 4510

PRODUCTION

1st 24 hrs. Nat. _____

1st 24 hrs. after shot _____

Gas _____ Cu. Ft.

Dry Hole _____

Abandoned _____

Date

MAR 30 1949

19

S. J. LEWIS

Scout

County **Stafford** State **Kansas**

Sec. **30** (Blk. Twp.) **25** (Sur. Rge.) **13W** Map No.

Operator **Atlantic Refg.**

Well No. **3** Farm **McCandless**

Elev. Location **NE SE SE**

FIRST REPORT
COMPLETE

990 Ft. From **S** Line **SE**

330 Ft. From **E** Line Quarter

1st. Report **APR 3 0 1952**

Completion **APR 3 0 1952**

Remarks **O.W.P.B.**

Spudding Date

Drilg. Data

Lens 3684 Simp sd 4248-prod. Arb 4285 still prod from Simp on pump TD 4310 5" @ 4308

16/3850-54 24/3834-40 set packer 4226 8000A

F 288 Bo plus 8/10 of 1 1/2 wtr. 23 Hrs. 203Bopd. from Lens Comp.