

Section 30 Township 25 Range 13W

Well No. #1 McCandless "B"

Company Beardmore, Lebow

NORTH

WEST

EAST

							0

SOUTH

Sec. 30 Twp. 25 R. 13 W ✓

Well No. # 1 McCandless "B" Farm

Beardmore & Lebow Company

Beardmore Drlg. Contractor


\_\_\_\_\_ Ft. from N. Line

330 Ft. from S. Line

330 Ft. from E. Line

\_\_\_\_\_ Ft. from W. Line

SE SE NE

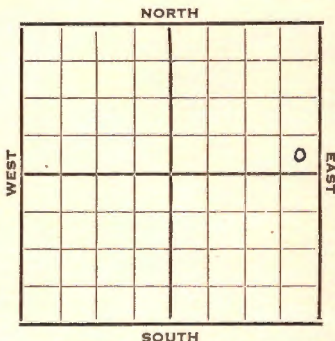

1951

**Elev. 1953'** REPORT

11/21 Location

1952

1/2

Spud 12-4-51

D & A TD 4399' 8" @ 1139'

**Lans. 3721'**

DST 3768-80' open 1 hr. rec 30' mud

**Miss 4128' Viola 4215' Cong. 4082'**

**Simp. 4319'**

DST 4319-68 open 45 min. rec 200' mud

200' water. **Arb. 4380'** TD 4399'

D & A

**ABANDONED**



County Stafford State Kansas

Sec. 30 (Blk. Twp.) 25 (Sur. Rge.) 13W Map No.

Operator Beardmore & Lebow

Well No. 1 Farm McCandless "B"

Elev. 1953 Location SE SE NE



330 Ft. From S Line NE

330 Ft. From E Line Quarter

1st. Report

Completion JAN 2 1952

Remarks

Beardmore Drlg. - Contr.

Spudding Date 12-4-51

Drlg. Data D & A TD 4399

8" @ 1139 Lans. 3721 DST 3768-80

open 1 hr. Rec. 30' mud Miss. 4128

Viola 4215 Cong. 4082 Simp. 4319

DST 4319-68 open 45 min. Rec. 200' mud

200' water Arb. 4380 TD 4399

D & A

J. E. TYRA