KANSAS

FORM 51 5M 1-42 PETROL


Stafford

C.O.W.W.O.

Section 30 Township 25 Range 13W

Well No. 1 J.C.McCandless

Company Atlantic

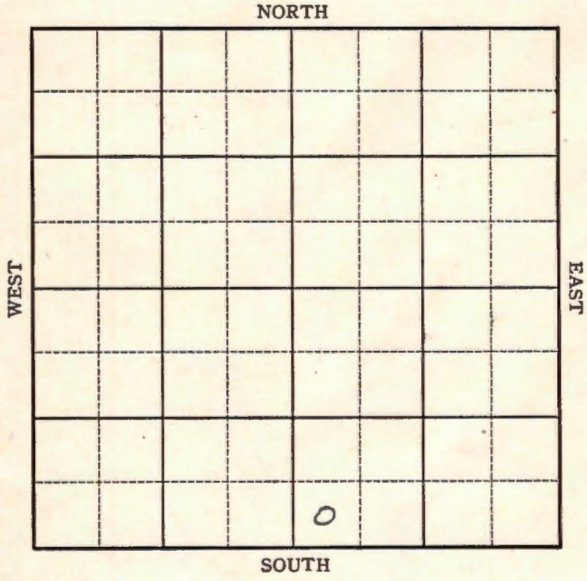

FORM 252-B
10M 8-51 TPCO.

Sec. ..... Twp. ..... R. .....

Well No. ..... Farm .....

..... Company


..... Contractor

..... Ft. from N. Line

..... Ft. from S. Line

..... Ft. from E. Line

..... Ft. from W. Line

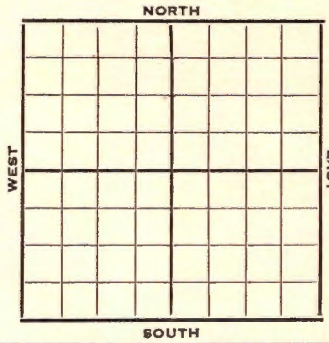

REPORT

1 J. C. McCandless

1952
10/8 Oil well TD 4323' Lans. 3705'
Miss 4080' Viola 4158' Simp sh.
4245', Simp. sd. 4251'
OTD 4323' 5" @ 4303' DP to 4277
20/3883-88 16/3869-73 16/3834-38
SP 3860 S/2 BOPH 4000 A
F/20 BOPH P/37 BO 12 hr. from Lans.
P/65 BO 12 hr from Simp.
F/158 BOPD from Lans.
Comp. P/143 BOPD from Simp.

COMPLETED

FORM 252-A
5M 9-43 GASS

KANSAS


KANSAS O.W.W.O.

Stafford

Sec. 30 Twp. 25 R. 13-W

Well No. #1 J. C. McCandless Farm

Atlantic Company

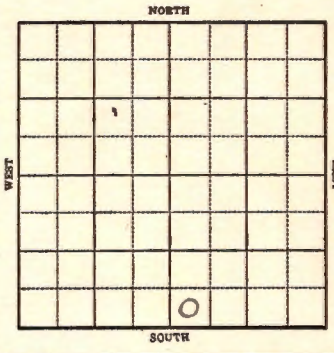

_____ Ft. from N. Line

330 Ft. from S. Line

_____ Ft. from E. Line

330 Ft. from W. Line

Elev. 1960

1943	REPORT
11/17	Location.
11/24	"
12/1	"
12/8	"
12-15	"
12/22	"
12/29	"
1944	
1-5	"
1-12	"
1/19	"
1/26	Rotary
2/2	8" @ 300 Drlg. 2052
2/8	3125 fsg.
2/15	Drlg. 3127
2/23	Lans 3705 TD 3888 SO
3/1	Miss 4048 Kind 4096 Viola 4162 Drlg. 4219

OVER

1944

3/8 Simp sh 4249
Simp sd 4259
Arb 4304
TD 4323
Run 5"

3/16 SLM 4323-19
Miss 4080
Viola 4158
Cherty Viola 4171
Simp. Sd 4255
Arb. 4289
5" @ 4303
Rust

3/22 "

3/29 500 acid SWb. 10 oil P.H.
10 hrs.

4/5 " " "

4/12 5" @ 4303
Simp Sd 4259
Arb 4304
TD 4323
Perf. Simp
2500 acid
Pump 734 Pot
Gravity 37

COMPLETED

1952

9/24 O.W.W.O.
Lans. 3705 Miss. 4080 Viola 4158
Simp. sh. 4245 Simp. sd 4251
OTD 4323' 5" @ 4304' DP 4277
20/ 3883-88 16/ 3869-73
16/ 3834-38 SP 3860 S/ 2 boph
4000 A F/ 20 boph P/ 37 bo From Lans.
12 hrs. P/ 65 BO 12 hr. From Simp.

10/1 Testing

Form 26 200 Bks 5-42 Petrol Stafford

KANSAS

Map No. 83 Sec. 30 Twp. 25 R. 13W


Well No. 1 J. C. McCandless

Atlantic Company

FIRST REPORT Contractor

SW SE

SECTION PLAT

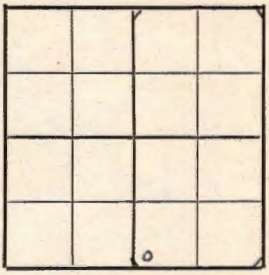

____ Ft. from N. Line

330 Ft. from S. Line

____ Ft. from E. Line

330 Ft. from W. Line

Wildcat

Location X

Rig up

Drilling and Remarks:

RECORD

Cased ____ in., ____ ft.

Sand

Gas

Oil

Total Depth

PRODUCTION

1st 24 hrs. Nat.

1st 24 hrs. after shot

Gas ____ Cu. Ft.

Dry Hole

Abandoned

Date

NOV 17 1943 19 S. J. LEWIS Scout

Form 26 200 Bks 5-42 Petrol Stafford

KANSAS

Map No. 83 Sec. 30 Twp. 25 R. 13W


Well No. 1 J. C. McCandless

Atlantic Company

COMPLETED Contractor

SW SE

SECTION PLAT

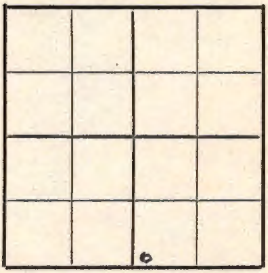

____ Ft. from N. Line

330 Ft. from S. Line

____ Ft. from E. Line

330 Ft. from W. Line

McCandless Pool

Location

Rig up

Drilling and Remarks:

Pump Set 4259

RT 4304

5" 4303

Perf Pump.

2 3/8 tbg

Pump 734 Pr

3/7 Gr

RECORD

Cased ____ in., ____ ft.

Sand

Gas

Oil

Total Depth 4343

PRODUCTION

1st 24 hrs. Nat.

1st 24 hrs. after shot

Gas ____ Cu. Ft.

Dry Hole)

Abandoned

Date

APR 1 2 1944 19 S. J. LEWIS Scout

FORM 275 FOR SALE BY KANSAS BLUE PRINT CO.

County Stafford State Kansas

Sec. 30 (Blk. Twp.) 25 (Sur. Rge.) 13W Map No.

Operator Atlantic Ref.

Well No. 1 Farm McCandless

Elev. 1960 Location SW SW SE



330 Ft. From S Line SE

330 Ft. From W Line Quarter

1st. Report SEP 21 1952

Completion

Remarks O.W.W.O.

Spudding Date

Drlg. Data

Lans. 3705 Miss. 4080 Viola 4158

Simp. sh. 4245 Simp. sd. 4251 OTD 4323

5" @ 4303 DP to 4277 20/ 3883-88

16/ 3869-73 16/ 3834-38 SP 3860

S/ 2 boph 4000 A F/ 20 boph

P/ 37 bo 12 hr. P/ 65 bo 12 hr.

from Lans. from Simp.

J. G. McGEHEE

FORM 275 FOR SALE BY KANSAS BLUE PRINT CO.

O.W.W.O.


County Stafford State Kansas

Sec. 30 (Blk. Twp.) 25 (Sur. Rge.) 13W Map No.

Operator Atlantic Ref.

Well No. 1 Farm McCandless

Elev. 1960 Location SW SW SE

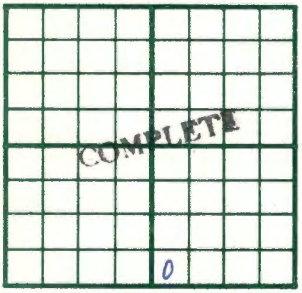

330 Ft. From S Line SE

330 Ft. From W Line Quarter

1st. Report

Completion OCT 8 1952

Remarks

O.W.W.O.

Spudding Date

Drlg. Data Oil well TD 4323

Lans. 3705 Miss. 4080 Viola 4158

Simp. sh. 4245 Simp. sd. 4251 OTD 4323

5" @ 4303 DP to 4277 20/ 3883-88

16/ 3869-73 16/ 3834-38 SP 3860

S/ 2 boph 4000 A F/ 20 boph

P/ 37 bo 12 hr. from Lans.

P/ 65 bo 12 hr. from Simp.

F/ 158 bopd from Lans.

Comp. P/ 143 bopd from Simp.

J. G. McGEHEE