

Section 31 Township 25 Range 13WWell No. #2 CampCompany Texas

McCandles Pocl

				0			

NORTH

WEST

EAST

SOUTH

Stafford

KANSAS

Sec. 23 Twp. 25 R. 13W

Well No. #2 Camp _____ Farm _____
Texas

McCandles Pool (B & R Drlg, Contr.) Company _____


330' Ft. from N. Line

_____ Ft. from S. Line

_____ Ft. from E. Line

330' Ft. from W. Line

NW NE

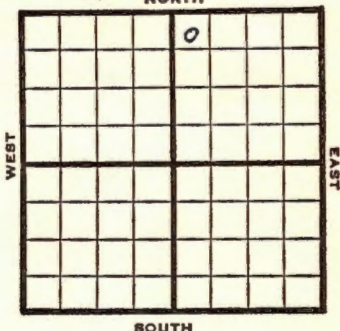

1949

Elev. 1959' REPORT

12/21

Location

12/28

Drlg 205'

1950

2/22

8" @ 1298'

5" @ 4273'

Lans 3694'

Viola 4167'

Simp sh 42 2'

Simp sd 4267'

158 BOPD

TD 4288'

COMPLETED

Kansas

McCandles Pool

Map No. _____ Sec. 31 Twp. 25 R. 13WWell No. 2 Camp

Texas

Company

B & R Drlg.

Contractor

NW NE

FIRST REPORT
SECTION PLAT330 Ft. from N. Line Ft. from S. Line Ft. from E. Line330 Ft. from W. Line

		0	

Stafford County

Location XRig up

Drilling and Remarks:

RECORD

Cased in., ft.Sand Gas Oil Total Depth

PRODUCTION

1st 24 hrs. Nat. 1st 24 hrs. after shot Gas Cu. Ft.Dry Hole Abandoned

Date

DEC 21 1949

19

S. J. LEWIS

Scout

Map No. _____ Sec. 31 Twp. 25 R. 13WWell No. 2 Camp

Texas

Company _____


Contractor _____

NW NE

El. 1959
SECTION PLAT330 Ft. from N. Line

_____ Ft. from S. Line

_____ Ft. from E. Line

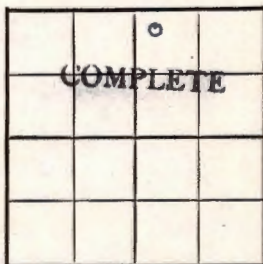330 Ft. from W. Line

Stafford County

Location _____

Rig up _____

Drilling and Remarks:

8" @ 1298

5" @ 4273

Lans 3694

Viola 4167

Simp Sh 4262

Simp Sd 4267

RECORD

Cased _____ in., _____ ft.

Sand _____

Gas _____

Oil _____

Total Depth 4288

PRODUCTION

1st 24 hrs. Nat. _____

1st 24 hrs. after shot _____

Gas _____ Cu. Ft.

Dry Hole _____

Abandoned _____

Date

158 BOPD

J. E. TYRA

Scout

FEB 22 1950 19