

KANSAS

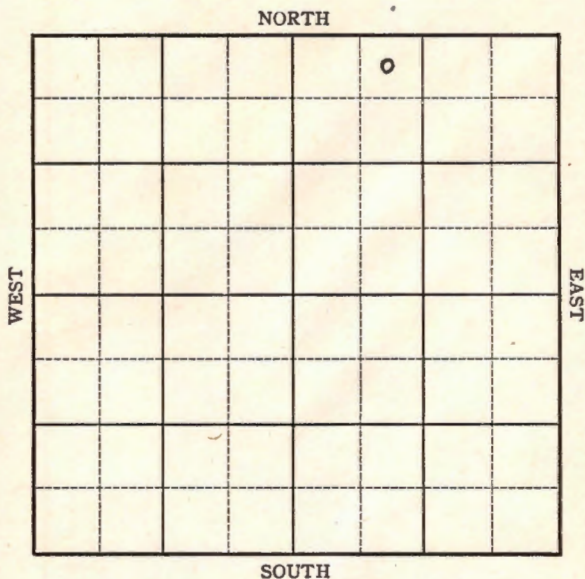
Stafford

FORM 51 5M 1-42 PETROL

Section 31 Township 25 Range 13 W

Well No. #1 E. G. Camp

Company Texas



KANSAS

Stafford

Sec. 31 Twp. 25 R. 13W

Well No. #1 E.G.Camp Farm

Texas

Company

McCandless

NORTH

330 Ft. from N. Line

Ft. from S. Line

Ft. from E. Line

990 Ft. from W. Line

WEST

EAST

SOUTH

4/15. 1964

1944

REPORT

5/10	Loc
5/17	Surface hole
5/24	8" @ 1255 Drlg. 1855
5/31	Drlg. 3116
6/7	Lans 3710 Drlg. 4130
6/15	Viola 4170 Simp Sd. 4264 Arb. 4316 - 18 TD 5" @ 4316 RUST
6/21	PB 4290 8 shots 4264-70
6/28	68 shots 4264-85 6000 acid shot swb 25 oil in 24 hrs

OVER

1944

7/12

Simp 4264

Arb 4316

5" @ 4316

Perf Simp

~~1000~~

1000 Acid

Pump 90 Pot

Gravity 37.0

TD 4318

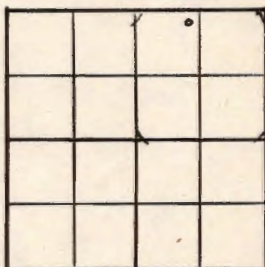
COMPLETED

KANSASPool Name McCandlesMap No. 83 Sec. 31 Twp. 25 R. 13WWell No. 1 E. G. CampTexas

Company

FIRST REPORT

Contractor

NE NW NE**SECTION PLAT**330 Ft. from N. Line Ft. from S. Line Ft. from E. Line990 Ft. from W. LineStafford CountyLocation XRig up

Drilling and Remarks:

RECORDCased in., ft.Sand Gas Oil Total Depth **PRODUCTION**1st 24 hrs. Nat. 1st 24 hrs. after shot Gas Cu. Ft.Dry Hole Abandoned

Date

MAY 10 194419S. J. LEWISScout

KANSASPool Name McCandlessMap No. 82 Sec. 31 Twp. 25 R. 13WWell No. 1 E. G. CampTexas

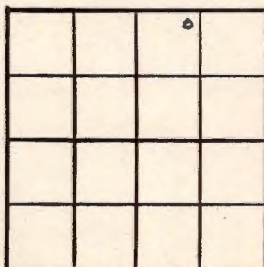
Company

COMPLETED

Contractor

NE NW NE

SECTION PLAT

330 Ft. from N. Line Ft. from S. Line Ft. from E. Line990 Ft. from W. Line

Stafford County

Location

Rig up

Drilling and Remarks:

*Smp. Sol 4264**Ce 7 4316**5" @ 4316**Prof Smp**1000 acid**Pmg 90 2X*

Date

3708

RECORD

Cased in. ft.Sand Gas Oil Total Depth 4318

PRODUCTION

1st 24 hrs. Nat. 1st 24 hrs. after shot Gas Cu. Ft.Dry Hole Abandoned

JUL 12 1944 19

S. J. LEWIS

Scout