


KANSAS Stafford County

Section 31 Township 25 Range 13W

Well No. #2 Shoop

Company Atlantic Prod.

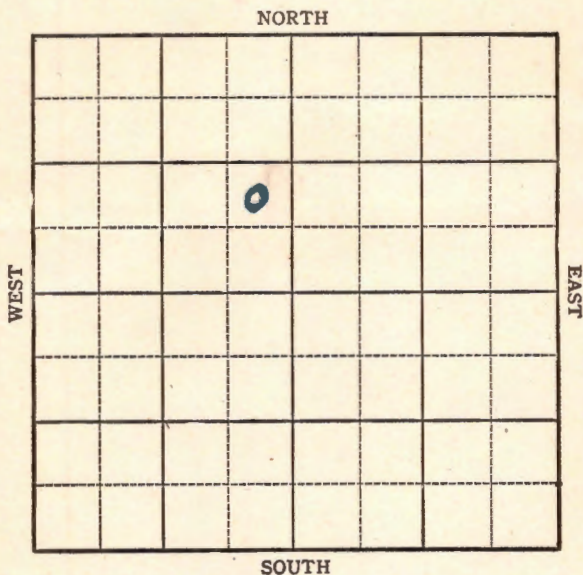

KANSAS

Stafford County

Sec. 31 Twp. 25S R. 13WWell No. #2, Shoop FarmAtlantic Prod. Company

McCandle ss

Ft. from N. Line

990 Ft. from S. Line


330 Ft. from E. Line

Ft. from W. Line

NE SE NW

Edw. 1962

NORTH

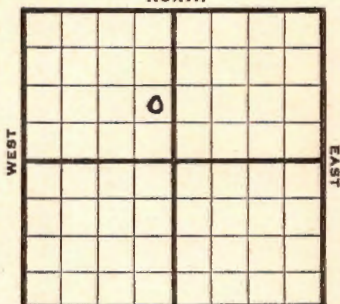

1945

R E P O R T

1-3 Location

1/10 RUR

1/17 8" @ 803
Drlg 970

1/26 Drlg. 2790'

1/31 Drlg. 3890'

2/7	Lans	3757
	Miss	4183
	Kind	4206
	Viola	4277
	Simp Sd	4343
	Arb	4393
	TD	4436

ABANDONED

Pool Name McCandlessMap No. 83 Sec. 31 Twp. 25 R. 13WWell No. 2 ShoopAtlantic Prod

Company

FIRST REPORT

Contractor

NE SE NW

SECTION PLAT

Ft. from N. Line

990

Ft. from S. Line

330

Ft. from E. Line

Ft. from W. Line

StaffordLocation X

Rig up

Drilling and Remarks:

RECORD

Cased _____ in., _____ ft.

Sand _____

Gas _____

Oil _____

Total Depth _____

PRODUCTION

1st 24 hrs. Nat. _____

1st 24 hrs. after shot _____

Gas _____ Cu. Ft.

Dry Hole _____

Abandoned _____

Date

JAN 3 1945 19S. J. LEWIS

Scout

Pool Name McCandlessMap No. K-83 Sec. 31 Twp. 25 R. 13WWell No. 2 ShoopAtlantic Prod CompanyABANDONED Contractor
NE SE NW

SECTION PLAT

 Ft. from N. Line990 Ft. from S. Line330 Ft. from E. Line Ft. from W. LineSt affordLocation Rig up

Drilling and Remarks:


RECORD

Cased in., ft.Sand Gas Oil Total Depth 4436

PRODUCTION

1st 24 hrs. Nat. 1st 24 hrs. after shot Gas Cu. Ft.Dry Hole Abandoned

Date

FEB 7 194519S. J. LEWISScout