

KANSAS

Stafford


Section 32 Township 25 Range 13WWell No. 1 Kipp TolandCompany Elbow
Ed Swearer et al

Wildcat

NORTH

WEST

EAST

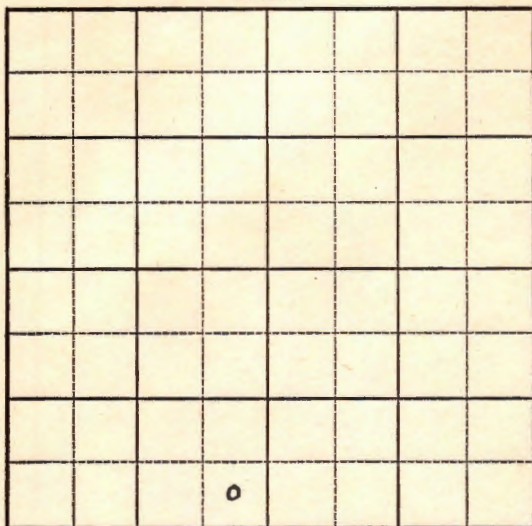

SOUTH

KANSAS

Sec. 32 Twp. 25 R. 13W
Well No. #1 Kipp Toland Farm
Ed Swearer et al Company

Wildcat

Ft. from N. Line

330'


Ft. from S. Line

330'

Ft. from E. Line

Ft. from W. Line

SE SW

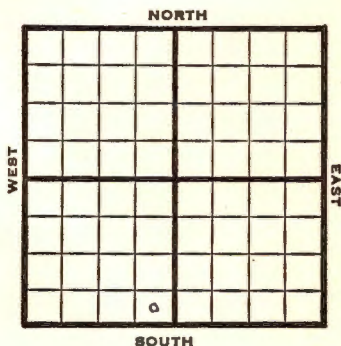

1949

Elev. 1948' REPORT

1/12

Location

1/19

"

1/26

8" @ 350'

2/2

Drlg 3067'

2/9

Lansing 3763'

Conglomerate 4192'

Drlg. 4219'

2/16

Viola 4281'

Simp. 4325'

Arb. 4419'

TD 4455'

ABANDONED

L-3763
1948
1815

Kansas


Map No. _____ Sec. 32 Twp. 25 R. 13WWell No. 1 Kipp

_____ Ed Swearer et al. _____ Company

_____ FIRST REPORT _____ Contractor

SE SW

SECTION PLAT

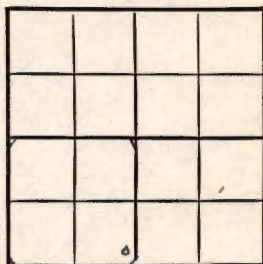

_____ Ft. from N. Line

330 _____ Ft. from S. Line330 _____ Ft. from E. Line

_____ Ft. from W. Line

Stafford County

RECORD

Location _____ X

Cased _____ in., _____ ft.

Rig up _____

Sand _____

Drilling and Remarks:

Gas _____

Oil _____

Total Depth _____

PRODUCTION

1st 24 hrs. Nat. _____

1st 24 hrs. after shot _____

Gas _____ Cu. Ft.

Dry Hole _____

Abandoned _____

Date

JAN 1 2 1949 19S. J. LEWIS Scout

Map No. 83 Sec. 32 Twp. 25 R. 13W

Well No. 1 Toland

Ed Swearer etal. Company

CORRECTION Contractor

SE SW

SECTION PLAT

 Ft. from N. Line

330 Ft. from S. Line

330 Ft. from E. Line

 Ft. from W. Line

Stafford County

RECORD

Location

Cased in., ft.

Rig up

Sand

Drilling and Remarks:

Gas

Oil

Total Depth

Reported as
#1 Kirpp

PRODUCTION

1st 24 hrs. Nat.

1st 24 hrs. after shot

Gas Cu. Ft.

Dry Hole

Abandoned

Date

JAN 19 1949 19

S. J. LEWIS Scout

Kansas

Wildcat

Map No. 83 Sec. 32 Twp. 25 R. 13WWell No. 1 Toland

Elbow et al.


Company

CORRECTION

Contractor

SE SW

SECTION PLAT

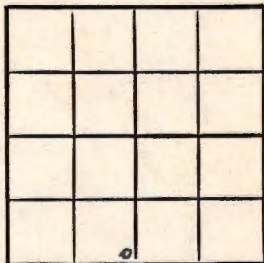 Ft. from N. Line330 Ft. from S. Line330 Ft. from E. Line Ft. from W. Line

Stafford County

Location Rig up

Drilling and Remarks:

Reported
Ed Swearer
etal.

RECORD

Cased in., ft.Sand Gas Oil Total Depth

PRODUCTION

1st 24 hrs. Nat. 1st 24 hrs. after shot Gas Cu. Ft.Dry Hole Abandoned

Date

JAN 26 1949 19

S. J. LEWIS Scout

Kansas


Map No. K83 Sec. 32 Twp. 25 R. 13WWell No. 1 TolandElboco etal.

Company

ABANDONED

Contractor

SE SW

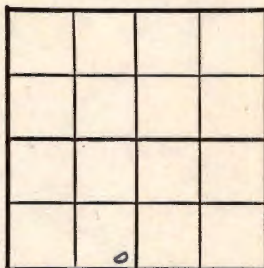E. 1, 1948
SECTION PLAT Ft. from N. Line330 Ft. from S. Line330 Ft. from E. Line Ft. from W. Line

Stafford County

Location Rig up

Drilling and Remarks:

Viola #281
King #325
Per #4419

RECORD

Cased in., ft.Sand Gas Oil Total Depth 4455

PRODUCTION

1st 24 hrs. Nat. 1st 24 hrs. after shot Gas Cu. Ft.Dry Hole Abandoned

Date

FEB 16 1949 19S. J. LEWIS

Scout