

Section 36 Township 25 Range 13WWell No. #1 WalterCompany M.B. Armer (& Phillips has $\frac{1}{2}$ int.)

NORTH

		0					

WEST

EAST

SOUTH

Stafford

KANSAS

Sec. 36 Twp. 25 R. 13W

Well No. #1 Walter Farm

M.B. Armer (Phillips Int.) Company

Armer- Contr. Contractor
Wildcat


Ft. from N. Line

330' Ft. from S. Line

990' Ft. from E. Line

Ft. from W. Line

SW SE SW

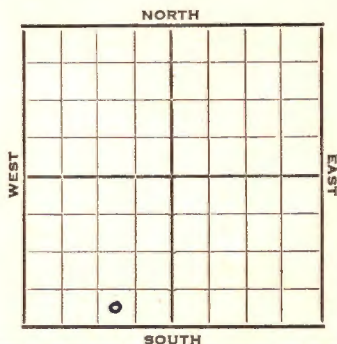

1952 *E. Armer 1914* REPORT

5/21 Spud 5-18-52
8" @ 246
Anhy 800
Drlg. 952'

5/28 Heeb. 3489 Br Li 3647
Lans. 3679 Drlg. 3710'

6/11 DST 3821-60, 1 hr. 30' gcm 120' HO&GCM
B KC 3976 Marm 3985
Miss 4091 KH 4153
Simp sh 4222 Simp. sd 4230
Arb. 4295

6/18 Schl RTD 4346 5" @ 4346
60/4224-44' SO 500 A 2 gal OPH
12/4132-36' NS PB 3848'
24/3822-28' SSO 1000 A
S/45 BO 45 mins then start flowing
Shut in overnight. S/45 BWPH MS
S/380 BW no oil, then wtr decreased,
oil increased.
S/27 BO & 2 BWPH. POP

6/25 NR

7/2 NR

7/9 NR

7/17 NR

7/23 "

OVER

1952

7/30

Spud 5-18-52

Oil Well TD 4346 8" @ 246

Anhy 800 Heeb. 3489

Br Li 3647 Lans. 3671

DST 3821-60 open 1 hr. rec. 30' gcm

120' ho&gcm B KC 3976 Marm. 3985

Miss. 4091 Kh. 4128

Misener 4132 Viola 4153

Simp sh 422 Simp sd 4230

Arb. 4295 TD 4346

5" @ 4346 60/ 4224-44 S/ 2 goph

500 A S/ 2 goph 12/ 4132-36

PB 3848 24/ 3822-28 SSO 1000 A

S/ 45 bo 45 min. SD overnite


S/ 45 bwph S/ 380 bw no oil

S/ 108 BO S/ 27 bo 2 bwph

Comp. 81 bopd 48% wtr.

COMPLETED

County **Stafford** State **Kansas**
 Sec. **36** (Blk.) **25** (Sur.) **13W** Map No.
 Operator **H. B. Armer (& Phillips has $\frac{1}{2}$ interest)**
 Well No. **1** Farm **Walter**
 Elev. Location **SW SE SW**

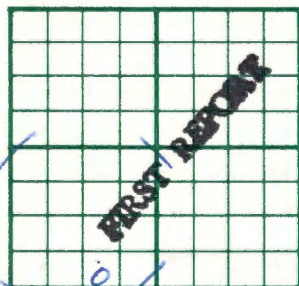

330 Ft. From **S** Line **SW**

990 Ft. From **E** Line **Quarter**

1st. Report **MAY 21 1952**

Completion

Remarks


Armer - Contr.

Spudding Date **5-18-52**

Drlg. Data **Wildcat**

8" @ 246 Anhy 800 Drlg. 952

J. G. McGEHEE

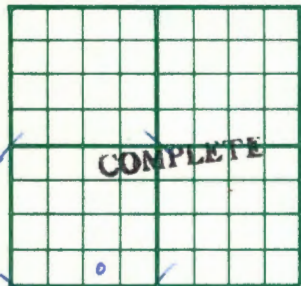County Stafford State KansasSec. 36 (Blk.) 25 (Sur.) 13W Map No.Operator M. B. Armer & PhillipsWell No. 1 Farm WalterElev. 1914 Location SW SE SW330 Ft. From S Line SW990 Ft. From E Line Quarter

1st. Report

Completion JUL 30 1952Remarks WildcatArmer - Contr.Spudding Date 5-18-52Drilg. Data Oil well TD 43468" @ 246 Anhy 800 Heeb. 3489Br. lime 3647 Lans. 3671 DST 3821-60open 1 hr. Rec. 30' gcm 120' ho & gcmB KC 3976 Marm. 3985 Miss. 4091Kh. 4128 Misener 4132 Viola 4153Simp. sh. 4222 Simp. sd. 4230Arb. 4295 TD 4346 5" @ 434660/ 4224-44 S/ 2 goph 500 A S/ 2 goph12/ 4132-36 PB 3848 24/ 3822-28 SSO1000 A S/ 45 bo 45 min. Shut downovernite S/ 45 bwph S/ 380 bw no oilS/ 108 bo S/ 27 bo 2 bwphComp. 81 bopd 48% water

J. G. McGEHEE