

KANSAS Stafford


Section 12 Township 25 Range 13W

Well No. 1 Fair

Company Musgrove Pet.

Leesburg Pool

NORTH

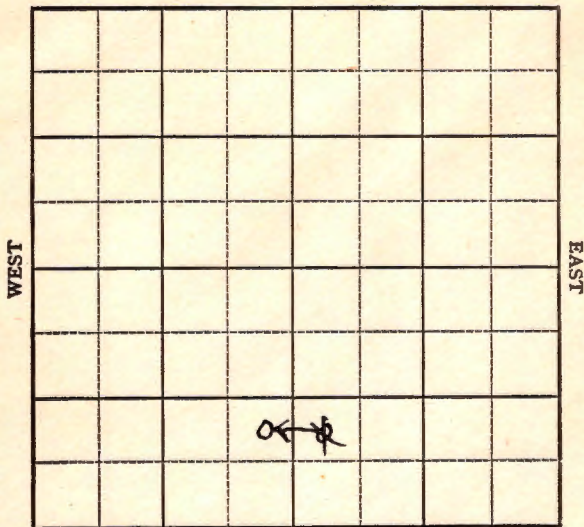

SOUTH

Sec. 12 Twp. 25 R. 13-W ✓

Well No. #1 Fair Farm

Musgrove Pet. Company
Leesburg Pool


_____ Ft. from N. Line

990 Ft. from S. Line

330 Ft. from E. Line

_____ Ft. from W. Line

NE SE SW

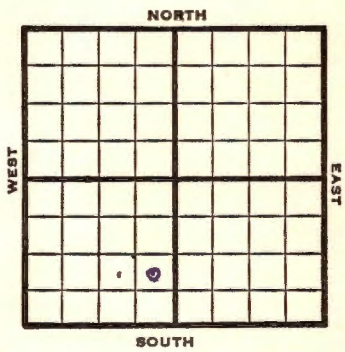

1948

Eli 1918' REPORT

11/3

Location

11/10

8" @ 300'
Drlg 2710'

11/16

Lansing 3602'
Viola 3971'

11/23

Drlg. 4030'
TD 4175'
Arb. 4160'
Aband.

ABANDONED

Map No. _____ Sec. 12 Twp. 25 R. 13W

Well No. 1 Fair

Musgrove Pet. _____ Company

FIRST REPORT

Contractor _____

NE SE SW

SECTION PLAT

_____ Ft. from N. Line

990 Ft. from S. Line

330 Ft. from E. Line

_____ Ft. from W. Line

Stafford County

Location X

Rig up _____

Drilling and Remarks:

RECORD

Cased _____ in., _____ ft.

Sand _____

Gas _____

Oil _____

Total Depth _____

PRODUCTION

1st 24 hrs. Nat. _____

1st 24 hrs. after shot _____

Gas _____ Cu. Ft.

Dry Hole _____

Abandoned _____

Date

NOV 3 1948 19

S. J. LEWIS Scout

