

KANSAS

Stafford


Form 51-5M-7-39-Palace

O.W.W.O.

Section 12 Township 25 Range 13-W

Well No. #2 M. N. Fair

Company Continental et al

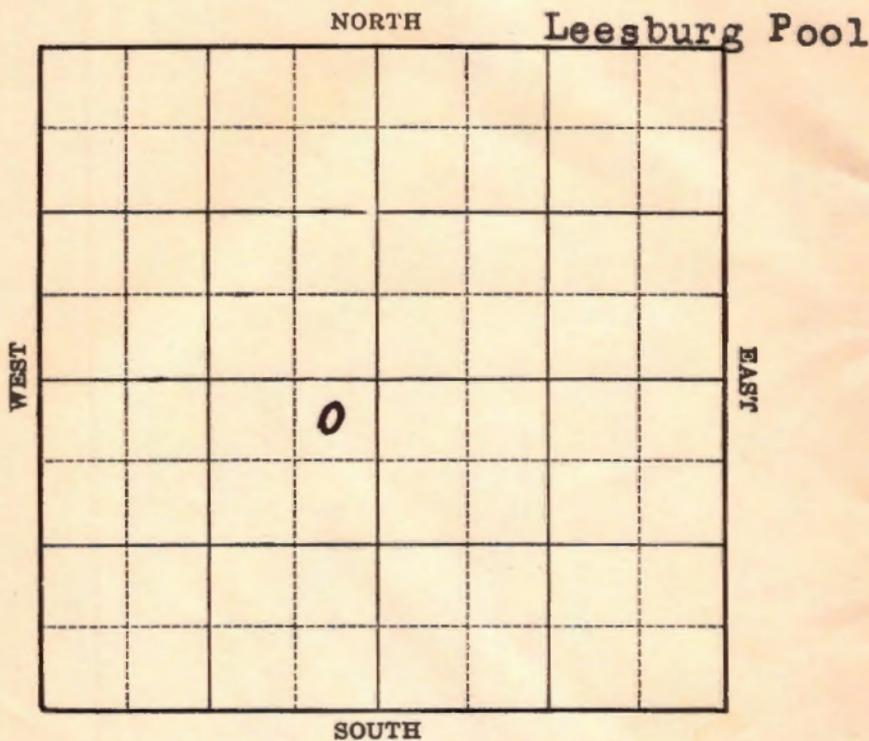



Sec. 12 Twp. 25 R. 13-W

Well No. #2 M. N. Fair Farm

Continental et al Company


(Leesburg)

330 Ft. from N. Line

_____ Ft. from S. Line

330 Ft. from E. Line

_____ Ft. from W. Line

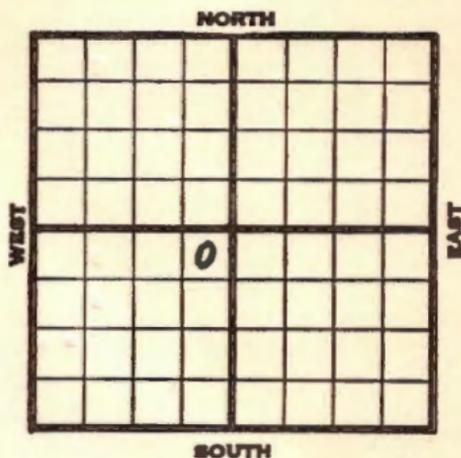

Elev. 1920

1940	REPORT
3/6	Bldg. rotary derrick.
3/14	Derrick.
3/21	10" - 457' Drlg. 2190'
3/28	Drlg. 3890'
4/4	Arb. 4098' T.D. 4103'
	7" - 4099' RUST.
4/12	T.D. 4145' 3900' oil.
4/18	" " " "
4/24	Arb. 4098'
	7" - 4099'
	T.D. 4145'
	Echometer potential 3910 bbls.
	Maximum 3000 bbls.
	COMPLETED
	O.W.W.O.
1952	
10/29	OTD 4145'
	Simp 4055', Arb. 4098'
	7" @ 4099 MICT
	OVER

1952

11/5 Retainer @ 4073'
sq Arb 48/4050-62, B/trace oil
Packer @ 4019', S/16 BO 73 hrs.

11/12 P/13 BO 2 hrs.

LL/19 Oil Well

TD 4145'

Simp. 4055', Arb 4098

OTD 4145

7" @ 4099

SP 4073, 48/4050-62, B/tr. oil

SP 4019, S/14 bo 13 hrs., P/13

bo 2 hrs., P/8½ bo 5 hrs.

Comp. 7½ bopd

COMPLETED

Map No. 83 Sec. 12 Twp. 25 R. 13W

Well No. 2 M. N. Fair

Continental etal Company

Contractor

COMPLETED

SECTION PLAT

NE SW

	0		

330 Ft. from N. Line

_____ Ft. from S. Line

330 Ft. from E. Line

_____ Ft. from W. Line

LEESBURG POOL

Location _____

Rig up _____

Drilling and Remarks:

*Act. 4098..
7" @ 4099*

*Echometer Pt
3910*

Maximum 3000

RECORD

Cased _____ in., _____ ft.

Sand _____

Gas _____

Oil _____

Total Depth 4145

PRODUCTION

1st 24 hrs. Nat. _____

1st 24 hrs. after shot _____

Gas _____ Cu. Ft.

Dry Hole _____

Abandoned _____

Date

APR 24 1940 19

S. J. LEWIS

Scout