

KANSAS


Stafford

FORM 51 5M 1-42 PETROL

Section 12 Township 25 Range 13-W

Well No. #3 S. M. McCune

Company Continental etal

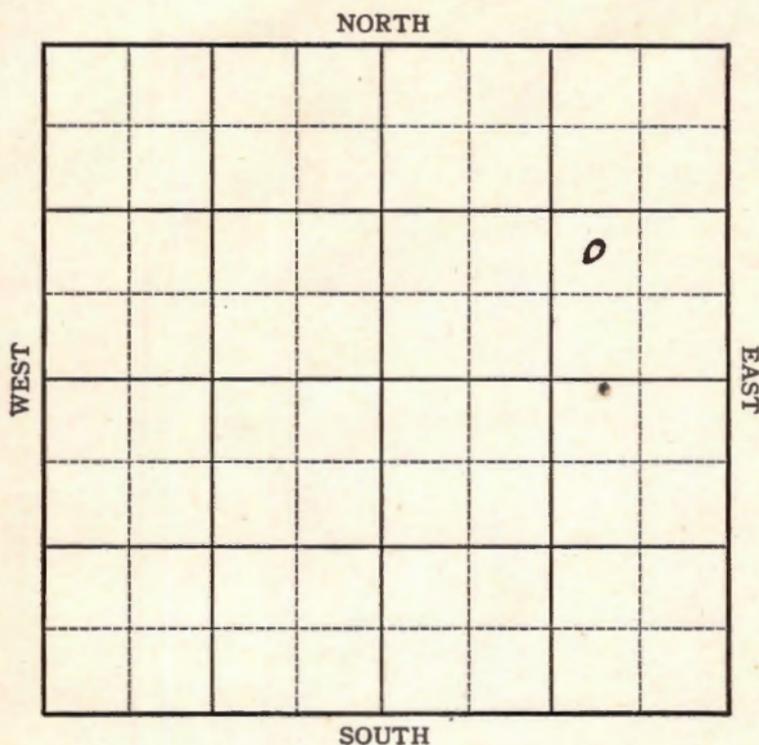

Sec. 12 Twp. 25 R. 13-W

Well No. #3 S. M. McCune Farm

Continental etal Company

Leesburg


_____ Ft. from N. Line

990 Ft. from S. Line

990 Ft. from E. Line

_____ Ft. from W. Line

Elev. 1916

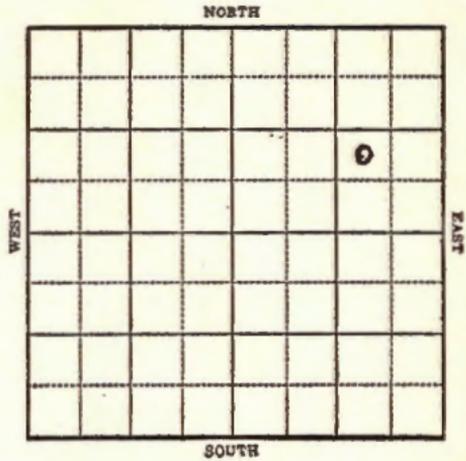

1943

R E P O R T

6/16 10" @ 285'
WOC.

6/23 Drlg. 2748'

6/30 Drlg. 3620'

7/7 No report.

7/15 Arb 4078-87 T.D.
7" @ 4080
RUST

7/21 "

7/28 T.D. 4094 swab 28 oil in 8 hrs.

8/4 Simp. 4022

7" @ 4080

Arb. 4078'

T.D. 4094'

Echo Pot 1818

Gravity 37.5

COMPLETED

Stafford

Map No. KANSAS Sec. 12 Twp. 25 R. 13W

Well No. 3 S. M. McCune

Continental etal. Company

FIRST REPORT Contractor

NW SE NE

_____ Ft. from N. Line

990 Ft. from S. Line

990 Ft. from E. Line

_____ Ft. from W. Line

SECTION PLAT

			o

LEESBURG POOL

Location _____

Rig up _____

Drilling and Remarks:

10" - 285'

W.O.C.

RECORD

Cased _____ in., _____ ft.

Sand _____

Gas _____

Oil _____

Total Depth _____

PRODUCTION

1st 24 hrs. Nat. _____

1st 24 hrs. after shot _____

Gas _____ Cu. Ft.

Dry Hole _____

Abandoned _____

Date

JUN 16 1943 19

S. J. LEWIS

Scout

KANSAS *83* **Stafford**
 Map No. _____ Sec. 12 Twp. 25 R. 13W

Well No. 3 S. M. McCune

Continental etal. Company

COMPLETED Contractor

NW SE NE

SECTION PLAT

_____ Ft. from N. Line
990 Ft. from S. Line
990 Ft. from E. Line
 _____ Ft. from W. Line

			o

LEESBURG POOL

Location _____

Rig up _____

Drilling and Remarks:

Swamp 4022
7° 4080
CR 44078
Ec hrd R 8/18/18

375

RECORD

Cased _____ in., _____ ft.
 Sand _____
 Gas _____
 Oil _____
 Total Depth 4094

PRODUCTION

1st 24 hrs. Nat. _____
 1st 24 hrs. after shot _____
 Gas _____ Cu. Ft.
 Dry Hole _____
 Abandoned _____

Date

AUG 4 1943 19

S. J. LEWIS Scout