


Section 12 Township 25 Range 13-W

Well No. 1 Mather

Company Continental et al

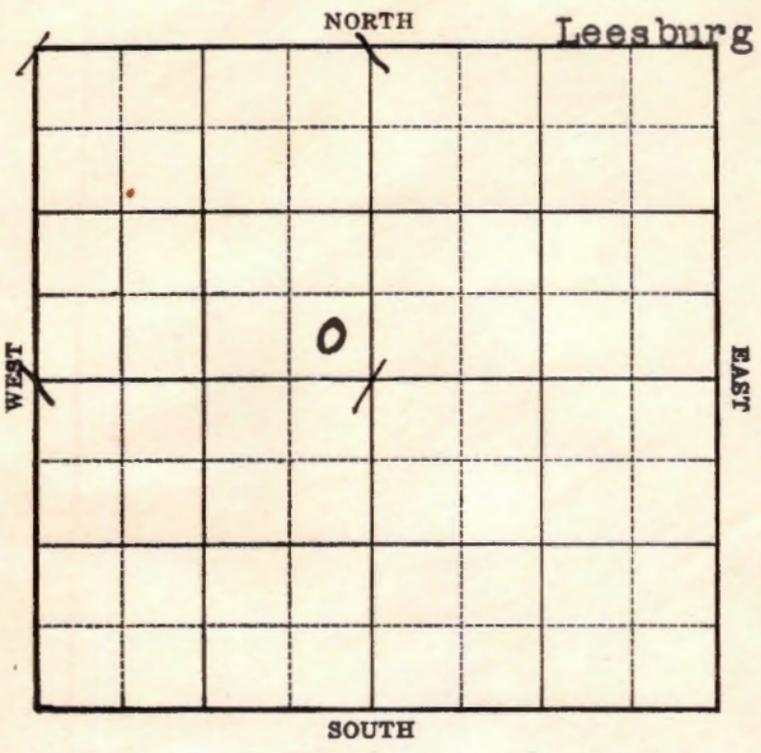

Sec. 12 Twp. 25 R. 13-W

Well No. #1 Mather Farm

Continental et al Company

(Leesburg)


\_\_\_\_\_ Ft. from N. Line

330 Ft. from S. Line

330 Ft. from E. Line

\_\_\_\_\_ Ft. from W. Line

**Elev. 1918'**

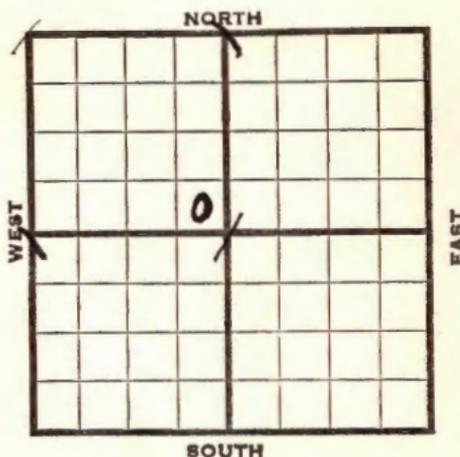

1939	REPORT
3/22	R.O.G.
3/31	R. R.
4/7	10" - 464' <b>Anhy 735'</b> Drlg. 1740'
4/14	Drlg. 3175'
4/21	<b>Viola 3945'</b> <b>Simp. sd. 4035'</b> <b>Arb. 4078'</b> T.D. 4081' 7" - 4079' R.U.S.T.
4/28	T.D. 4098' 3800' oil.
5/5	T.D. 4125' 3975' oil. Run tubg
5/10	<b>Viola 3945'</b> <b>Arb. 4078'</b> 7" - 4079' T.D. 4125' Pump 2939 bbls.
	<b>COMPLETED</b>

O.W.W.O.

~~26~~

FORM 513 SUNRAY

County Stafford Elev. \_\_\_\_\_  
 Sec. 12 Twp. 25 Rge. 13W  
 Company Continental  
 Farm Name T. Mather No. 1

Co.  
Lse.  
Mo.  
Sec.  
T.  
R.

TOPS	DEPTH	LOG	DATUM	Loc. in Sec.										
Anh.		735		SE SE NW										
Tp.		3170		<u>QW</u>										
H.														
Tr.														
Dg.														
Bl.														
L.		3550		Geol. _____										
K.C.				Contr. _____										
B.K.C.														
Ce.		3865												
C.														
M.				Pool										
M.				<u>Leesburg</u>										
K.														
Mz.														
Me.														
V.		3915		<table border="1"> <tr> <td>SEP</td> <td>18 '57</td> </tr> <tr> <td></td> <td></td> </tr> <tr> <td></td> <td></td> </tr> <tr> <td></td> <td></td> </tr> <tr> <td></td> <td></td> </tr> </table>	SEP	18 '57								
SEP	18 '57													
S.		4035												
S.														
A.		4078												
R.														
Pe.														
G.														
T.D.														

FIRST REPORT COMPLETE

Date Comm. 8-27-57  
OTD 4125 7" @ 4079 PB 3900  
40/ 3837-47 dry PB 3820 41/ 3758-68  
B/ 16 goph 4 hr. 1000 A F/ 80 bo 1/2 hr.  
Comp. 105 bopd 5 bw



Map No. 83 Sec. 12 Twp. 25 R. 13W

Well No. 1 Mather

Continental etal

Company

Contractor

**COMPLETED**

**SECTION PLAT**

**SE NW**

\_\_\_\_\_ Ft. from N. Line

330 Ft. from S. Line

330 Ft. from E. Line

\_\_\_\_\_ Ft. from W. Line


**LEESBURG POOL**

Location \_\_\_\_\_

Rig up \_\_\_\_\_

Drilling and Remarks:

*Viola 3945*

*Cr. & 4078*

*7" C 4079.*

*Pump. 2939*

**RECORD**

Cased \_\_\_\_\_ in., \_\_\_\_\_ ft.

Sand \_\_\_\_\_

Gas \_\_\_\_\_

Oil \_\_\_\_\_

Total Depth 4125.

**PRODUCTION**

1st 24 hrs. Nat. \_\_\_\_\_

1st 24 hrs. after shot \_\_\_\_\_

Gas \_\_\_\_\_ Cu. Ft.

Dry Hole \_\_\_\_\_

Abandoned \_\_\_\_\_

Date

MAY 10 1939

19

S. J. LEWIS

Scout