


P.W.W.O.

Section 12 Township 25 Range 13-W

Well No. #1 McCune

Company Continental et al

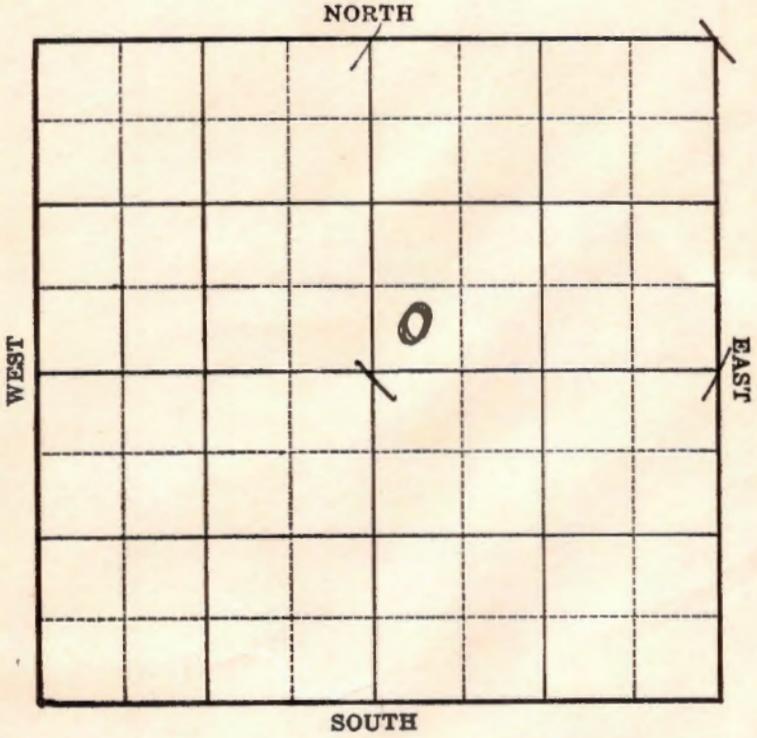

KANSAS

Stafford

Sec. 12 Twp. 25 **O.W.W.O.** R. 13-W

Well No. #1 McCune Farm

Continental et al Company


 Ft. from N. Line

330 Ft. from S. Line

 Ft. from E. Line

330 Ft. from W. Line

Elev. 1920

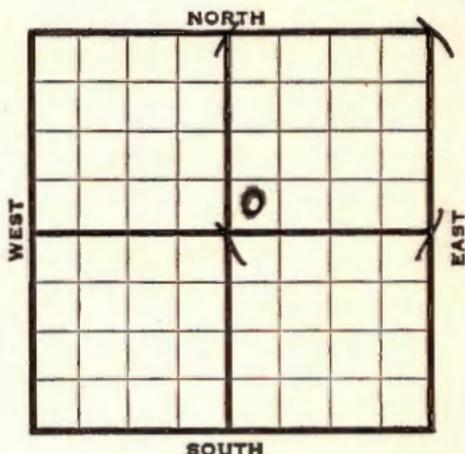

1938	REPORT
11/22	Location
12/2	"
12/9	B. R. R.
12/15	10" - 437'. Anhy 730'. Drlg. 1780'.
12/23	Drlg. 3315'.
12/30	(Mystery well)
1939	
1/6	Arb. 4069-91'. T. D. 6" - 4070'. Drilled plug. S. O. C. O.
1/7	Drilled plugs Filled up 3800' oil in 3 hrs. Bldg. tanks (Tel)
1/13	3700' oil in 3 hrs. Gravity 39.3 at 70'. Swab 6 hrs. and did not lower fluid below 1500' from top.
1/20	Testing.
1/27	"
	OVER

County **Stafford** State **O.W.W.O.**

Sec. **12** (Blk. **25**) (Sur. Rge.) **13W** Map No.

Operator **Continental Oil etal.**

Well No. **1** Farm **S. M. McCune**

Elev. Location **SW SWNE**

FIRST REPORT											
COMPLETE											

330 Ft. From **8** Line **NE**

330 Ft. From **W** Line Quarter

1st. Report **APR 6 1955**

Completion **APR 6 1955**

Remarks **O.W.W.O.**

O.W.W.O.

Spudding Date

Drlg. Data **Oil well TD 4091**

Simp. 4020 Arb. 4069 OTD 4091

6" @ 4071 PB 4052 59/ 4020-35 frac

Comp. 10 bopd

Handwritten initials

FABEN GILSTRAP

Map No. 83 Sec. 12 Twp. 25 R. 13W

Well No. 1 McCune

Continental etal Company

COMMUNITY Deal

CONT 68.8 Contractor

Shell 16.8

C.S. 0 SECTION PLAT

FIRST REPORT


SW NE

_____ Ft. from N. Line

330 Ft. from S. Line

_____ Ft. from E. Line

330 Ft. from W. Line

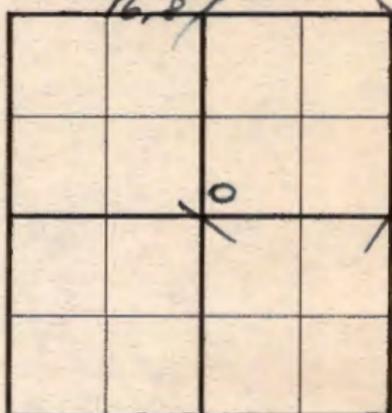

Location X

Rig up _____

Drilling and Remarks:

RECORD

Cased _____ in., _____ ft.

Sand _____

Gas _____

Oil _____

Total Depth _____

PRODUCTION

1st 24 hrs. Nat. _____

1st 24 hrs. after shot _____

Gas _____ Cu. Ft.

Dry Hole _____

Abandoned _____

Date

NOV 22 1938 19

H. D. Hatfield Scout

Stafford

Map No. 83 Sec. 12 Twp. 25 R. 13W

Well No. 1 McCune

Continental etal Company

Contractor

COMPLETED

SECTION PLAT

SW NE

		0	

Ft. from N. Line

330 Ft. from S. Line

Ft. from E. Line

330 Ft. from W. Line

LEESBURG POOL

Location _____

Rig up _____

Drilling and Remarks:

P-674/8

*Pot 2022
NAT*

RECORD

Cased 6 in., 4070 ft.

Sand Arb 4069

Gas _____

Oil _____

Total Depth 4091

PRODUCTION

1st 24 hrs. Nat. _____

1st 24 hrs. after shot _____

Gas _____ Cu. Ft.

Dry Hole _____

Abandoned _____

Date

FEB 1 - 1939

19

E. D. Hatfield Scout

