

Sec. 13 Twp. 25 R. 13-W

Well No. #2 Russell Farm

Continental & Cities Ser. Company


Leesburg

330 Ft. from N. Line

_____ Ft. from S. Line

990 Ft. from E. Line

_____ Ft. from W. Line

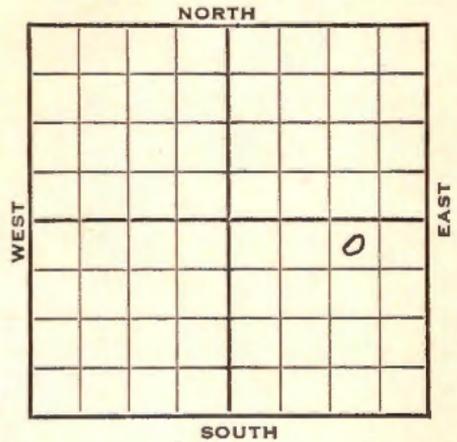


NW NE SE **Elev. 1908**

1943	REPORT
1/13	10"-280' Waiting on cement.
1/20	Drlg. 2750'
1/27	Drlg. 3945'.
2/3	Simp. sd. 4107
	Arb. 4146
	T.D. 4161' stains.
2/10	TD4320
	7" Casing set 4225'
	SWD.
2/17	Arb. 4146
	Sand 4370
	7" @ 4225'
	T.D. 4409'
	SWD
	ABANDONED

Section 13 Township 25 Range 13-W

Well No. #2 Russell

Company Continental & Cities Service Oil

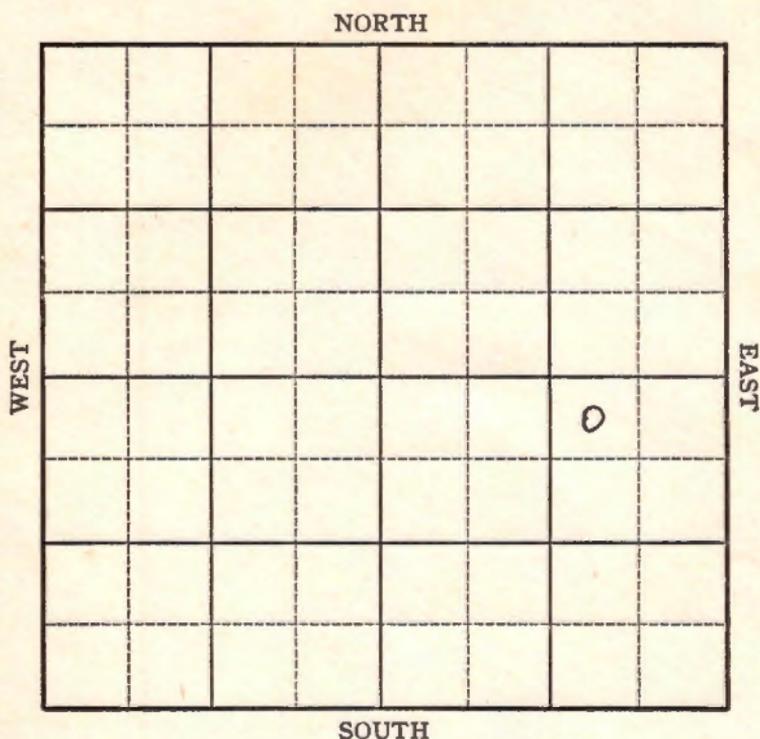

O.W.W.O.

S-513-B

County Stafford Elev. _____
 Sec. 13 Twp. 25 Rge. 13W
 Company Continental Oil
 Farm Name Maggie Russell No. 2

TOPS	DEPTH	LOG	DATUM
Anh.			
Tp.			
H.			
Tr.			
Dg.			
B.L.			
L.	3612		
K.C.	3800		
B.K.C.			
Ce.			
C.			
M.			
M.			
K.			
Mz.			
Mq.			
V.			
S.	4029		
S.	4082		
A.			
R.			
Pf.			
G.			
T.D.			

Loc. in Sec. _____
SE NW NE
O.W.W.O.
 Geol. **O.W.W.O.**
 Contr. _____
 Pool **Leesburg**

FIRST REPORT
 SEP 3 '58
COMPLETE

Date Comm. OTD 4121 6" @ 4083 PB 3900
40/ 3767-77 B/ 23 go 13 gwph 3 hr.
3000 A S/ 4 1/2 boph 2 bwph 12 hr.
PB 3760 40/ 3740-50 3000 A
S/ 14 boph 1 bwph 6 hr. CO 3900
Comp. 135 bopd 15 bw

Co.
Lse.
No.
Sec.
T.
R.

KANSAS

Map No. 83 Sec. 13 Twp. 25 R. 13W

Well No. 2 Russell

Continental & Cities Company

FIRST REPORT

Service Oil Contractor

NW NE SE

SECTION PLAT

330 Ft. from N. Line

_____ Ft. from S. Line

990 Ft. from E. Line

_____ Ft. from W. Line

			o

LEESBURG POOL

Location _____

Rig up _____

Drilling and Remarks:

10"-280'

**Waiting on
cement**

RECORD

Cased _____ in., _____ ft.

Sand _____

Gas _____

Oil _____

Total Depth _____

PRODUCTION

1st 24 hrs. Nat. _____

1st 24 hrs. after shot _____

Gas _____ Cu. Ft.

Dry Hole _____

Abandoned _____

Date

JAN 13 1943 19

S. J. LEWIS Scout

KANSAS

Map No. 83 Sec. 13 Twp. 25 R. 13W

Well No. 2 Russell

Continental & Cities Company

~~COMPLETED~~

Service Oil
Contractor

Abandoned
(L.S.)

NW NE SE

SECTION PLAT

330 Ft. from N. Line

_____ Ft. from S. Line

990 Ft. from E. Line

_____ Ft. from W. Line

			0

LEESBURG POOL

Location _____

Rig up _____

Drilling and Remarks:

Core 4146
Sand 4370
7" @ 4225.

S.W. II

RECORD

Cased _____ in., _____ ft.

Sand _____

Gas _____

Oil _____

Total Depth 4409

PRODUCTION

1st 24 hrs. Nat. _____

1st 24 hrs. after shot _____

Gas _____ Cu. Ft.

Dry Hole _____

Abandoned _____

Date

FEB 17 1943

19

S. J. LEWIS

Scout