

# KANSAS

FORM 51 5M 4-41 PETROL


Stafford

Section 13 Township 25 Range 13-W

Well No. #2 Russell

Company Continental e t al

NORTH Leesburg Pool

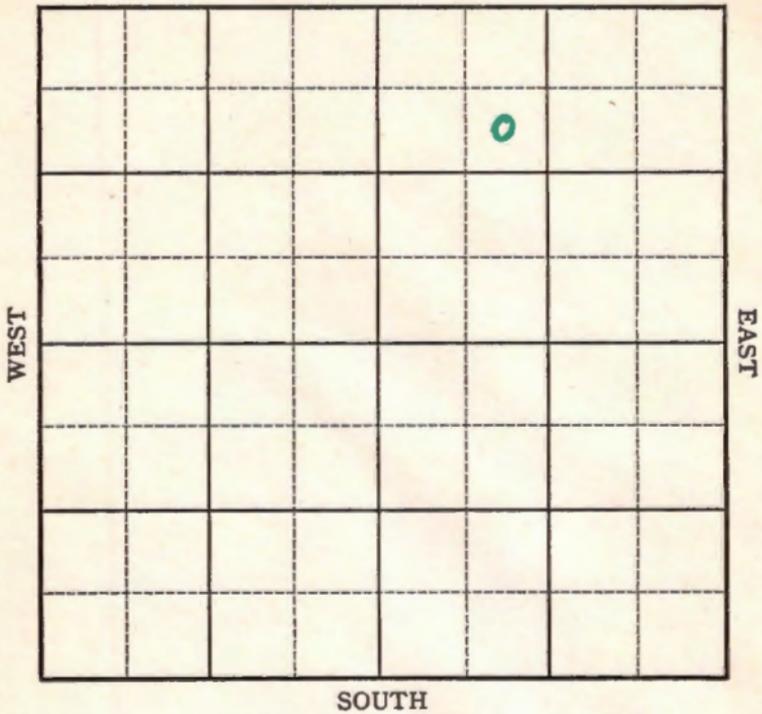



Stafford **KANSAS**Map No. 83 Sec. 13 Twp. 25 R. 13WWell No. 2 RussellContinental etal. Company**FIRST REPORT** Contractor

SE NW NE

990 Ft. from N. Line

\_\_\_\_\_ Ft. from S. Line

\_\_\_\_\_ Ft. from E. Line

990 Ft. from W. Line

## SECTION PLAT


## LEESBURG POOL

Location \_\_\_\_\_

Rig up \_\_\_\_\_

Drilling and Remarks:

10" - 281'Waiting on cement

## RECORD

Cased \_\_\_\_\_ in., \_\_\_\_\_ ft.

Sand \_\_\_\_\_

Gas \_\_\_\_\_

Oil \_\_\_\_\_

Total Depth \_\_\_\_\_

## PRODUCTION

1st 24 hrs. Nat. \_\_\_\_\_

1st 24 hrs. after shot \_\_\_\_\_

Gas \_\_\_\_\_ Cu. Ft.

Dry Hole \_\_\_\_\_

Abandoned \_\_\_\_\_

Date

JUN 17 1942

19

S. J. LEWIS Scout

Map No. 83 Sec. 13 Twp. 25 R. 13WWell No. 2 RussellContinental etal. CompanyCOMPLETED Contractor

SE NW NE

## SECTION PLAT


990 Ft. from N. Line

\_\_\_\_\_ Ft. from S. Line

\_\_\_\_\_ Ft. from E. Line

990 Ft. from W. LineLEESBURG POOL

## RECORD

Location \_\_\_\_\_

Cased \_\_\_\_\_ in., \_\_\_\_\_ ft.

Rig up \_\_\_\_\_

Sand \_\_\_\_\_

Drilling and Remarks:

Gas \_\_\_\_\_

Oil \_\_\_\_\_

Total Depth 4121

## PRODUCTION

1st 24 hrs. Nat. \_\_\_\_\_

1st 24 hrs. after shot \_\_\_\_\_

Gas \_\_\_\_\_ Cu. Ft.

Dry Hole \_\_\_\_\_

Abandoned \_\_\_\_\_

*Ar 84082*  
*6" @ 4083*  
*Echo Pt 3000*

*375 92*

Date

JUL 29 1942 19 S. J. LEWIS Scout