


Section 12 Township 25 Range 13-W

Well No. #2 Saunders

Company Continental ^{oil} ~~etc.~~

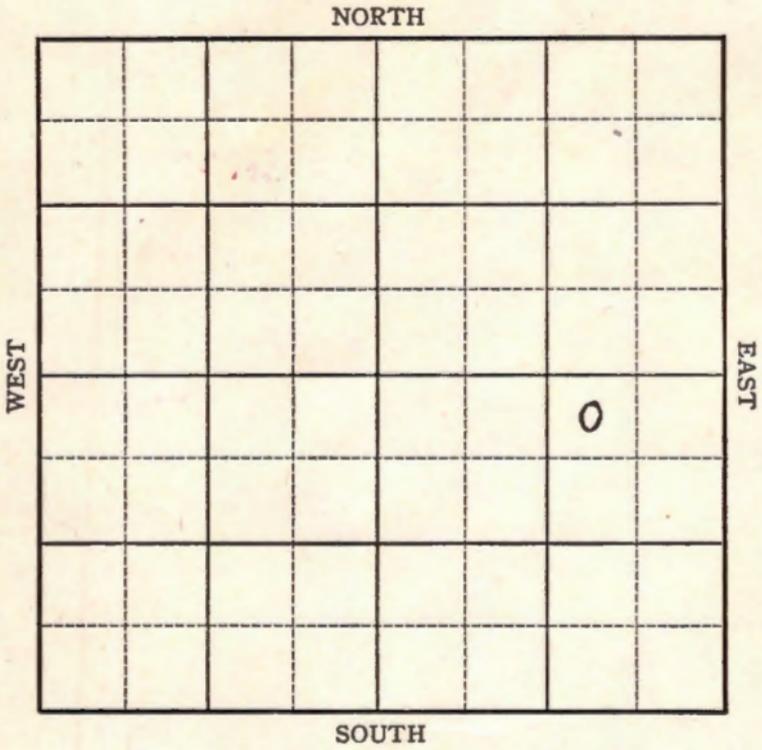

O.W.W.O.

FORM 252-A
5M 9-42 GASS

KANSAS

Stafford

Sec. 12 Twp. 25 R. 13-W

Well No. #2 Saunders Farm

Continental ^{oil} ~~gas~~ Company


Leesburg Pool

330 Ft. from N. Line

 Ft. from S. Line

990 Ft. from E. Line

 Ft. from W. Line

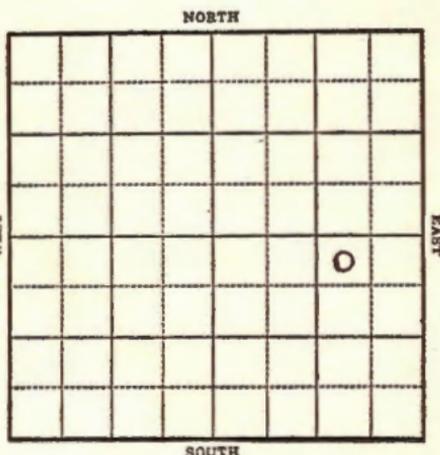

NW NE SE EL. 1919

1943

R E P O R T

2/10 Derrick

2/17 "

2/24 "

3/3 "

3/10 "

3/17 "

3/24 10" @ 280' WOC.

3/31 Anhy 700 Drlg. 2910

4/7 **Topeka 3116**

Drlg. 3940'

4/14 **Arb 4123-26 T.D.**

7" @ 4124 RUST.

4/21 T.D. 4133 swab 142 oil 8½ hrs.

4/28 **Arb. 4123**

7" @ 4124'

T.D. 4133'

Pump 214 Pot.

Gravity 37.6

COMPLETED

OVER

1955
6/22

O.W.W.O.

7" @ 4123 FB 4093 44/4071-4082'
frac. P/45 BO 21 hr. P/13 BO 16 hr.
P/10 BO 8 hr. P/5 BO 7 hr. Comp.
S. 4080' A. 4127'
TD 4132'

FIRST REPORT
↓
COMPLETED

KANSAS

Map No. 83 Sec. 12 Twp. 25 R. 13W

Well No. 2 Saunders

Continental etal. Company

FIRST REPORT Contractor

NW NE SE

SECTION PLAT

330 Ft. from N. Line

_____ Ft. from S. Line

990 Ft. from E. Line

_____ Ft. from W. Line

			o

LEESBURG POOL

Location _____

Rig up _____

Drilling and Remarks:

Derrick

RECORD

Cased _____ in., _____ ft.

Sand _____

Gas _____

Oil _____

Total Depth _____

PRODUCTION

1st 24 hrs. Nat. _____

1st 24 hrs. after shot _____

Gas _____ Cu. Ft.

Dry Hole _____

Abandoned _____

Date

FEB 1 0 1943 19

S. J. LEWIS Scout

KANSAS

Stafford

Map No. 83 Sec. 12 Twp. 25 R. 13W

Well No. 2 Saunders

Continental et al. Company

COMPLETED

Contractor

NW NE SE

SECTION PLAT

330 Ft. from N. Line

_____ Ft. from S. Line

990 Ft. from E. Line

_____ Ft. from W. Line

			0

LEESBURG POOL

Location _____

Rig up _____

Drilling and Remarks:

Ar 4/23
7" @ 4/24
Pump 214 PD

376 G

RECORD

Cased _____ in., _____ ft.

Sand _____

Gas _____

Oil _____

Total Depth 4133

PRODUCTION

1st 24 hrs. Nat. _____

1st 24 hrs. after shot _____

Gas _____ Cu. Ft.

Dry Hole _____

Abandoned _____

Date

APR 28 1943 19

S. J. LEWIS Scout

O.W.W.O.

FORM 513 REV. SUNRAY

O.W.W.O.

County Stafford Elev. 1919
 Sec. 12 Twp. 25 Rge. 13W
 Company Continental Oil
 Farm Name E. C. Saunders No. 2

TOPS	DEPTH	LOG	DATUM	Loc. in Sec.
Anh.				NW NE SE
Tp.				
H.				
Tr.				
Dg.				
Bl.				
L.				Geol.
K.C.				Contr.
B.K.C.				
Ce.				
C.				
M.				Pool
M.				Leesburg
K.				
Mz.				
Me.				
V.	4080			<div style="border: 1px solid black; padding: 5px; text-align: center;"> <p>FIRST REPORT</p> <p>JUN 22 '55</p> <p>COMPLETE</p> </div>
S.				
S.	4127			
A.				
R.				
PE.				
G.				
TD.	4132			

Date Comm. 7" @ 4123 PB 4093 44/ 4071-4082
frac P/ 45 bo 21 hr. P/ 13 bo 16 hr
P/ 10 bo 8 hr. P/ 5 bo 7 hr. Comp.

Co.
Lse.
No.
Sec.
T.
R.