

KANSAS


Form 51-5M-11-38-Palace

Stafford

Section 13 Township 25 Range 13-W

Well No. 1 Boland

Company Continental et al

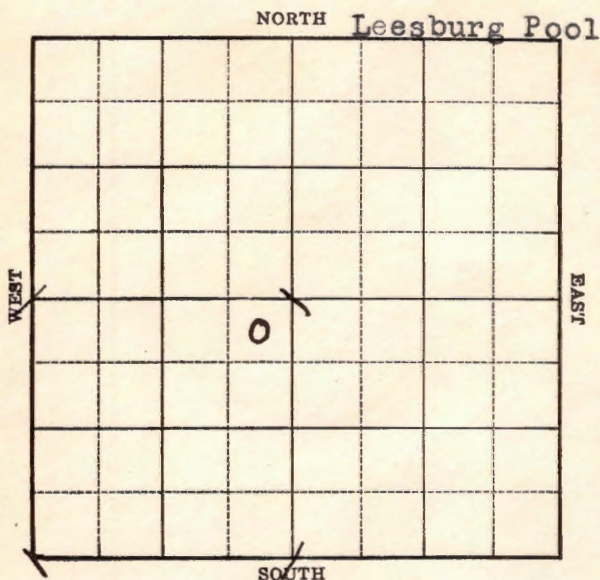

Stafford

Sec. 13 Twp. 25 R. 13-W

Well No. #1 Boland Farm

Continental et al Company

(Leesburg)


330 Ft. from N. Line

Ft. from S. Line

330 Ft. from E. Line

Ft. from W. Line

Elev. 1913

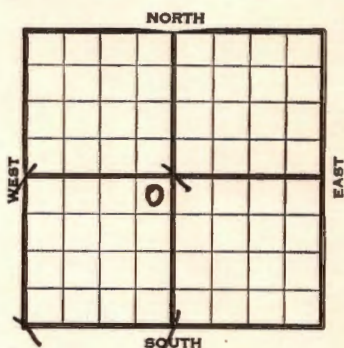
[illegible]

Stafford

KANSASMap No. 83 Sec. 13 Twp. 25 R. 13WWell No. 1 Boland**Continental etal**

Company

Contractor

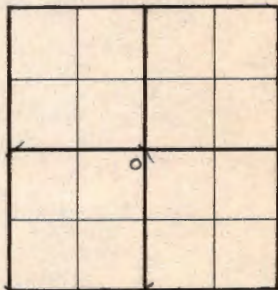FIRST REPORT**NE SW**330 Ft. from N. Line Ft. from S. Line330 Ft. from E. Line Ft. from W. Line**SECTION PLAT****LEESBURG POOL**Location Rig up

Drilling and Remarks:

RR**RECORD**Cased in., ft.Sand Gas Oil Total Depth **PRODUCTION**1st 24 hrs. Nat. 1st 24 hrs. after shot Gas Cu. Ft.Dry Hole Abandoned

Date

MAY 17 1939

19

S. J. LEVINS

Scout

Stafford

KANSAS

Map No. 83 Sec. 13 Twp. 25 R. 13WWell No. 1 Boland

Continental etal

Company

Contractor

ABANDONED

SECTION PLAT


NE SW

330 Ft. from N. Line

Ft. from S. Line

330 Ft. from E. Line

Ft. from W. Line

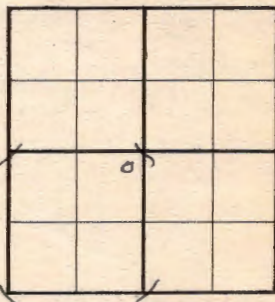

LEESBURG POOL

Location _____

Rig up _____

Drilling and Remarks:

*CR 84165**7" @ 4166**1000 cu ft**4FW*

RECORD

Cased _____ in., _____ ft.

Sand _____

Gas _____

Oil _____

Total Depth 4175 1/2

PRODUCTION

1st 24 hrs. Nat. _____

1st 24 hrs. after shot _____

Gas _____ Cu. Ft.

Dry Hole _____

Abandoned _____

Date

JUN 28 1939

19

S. J. LEWIS

Scout