

KANSAS O.W.W.O.

FORM 51 5M 10-41 PETROL

Stafford


Section 13 Township 25 Range 13-W

Well No. #2 Geo. Russell

Company Continental & Cities Service

Leesburg Pool

NORTH

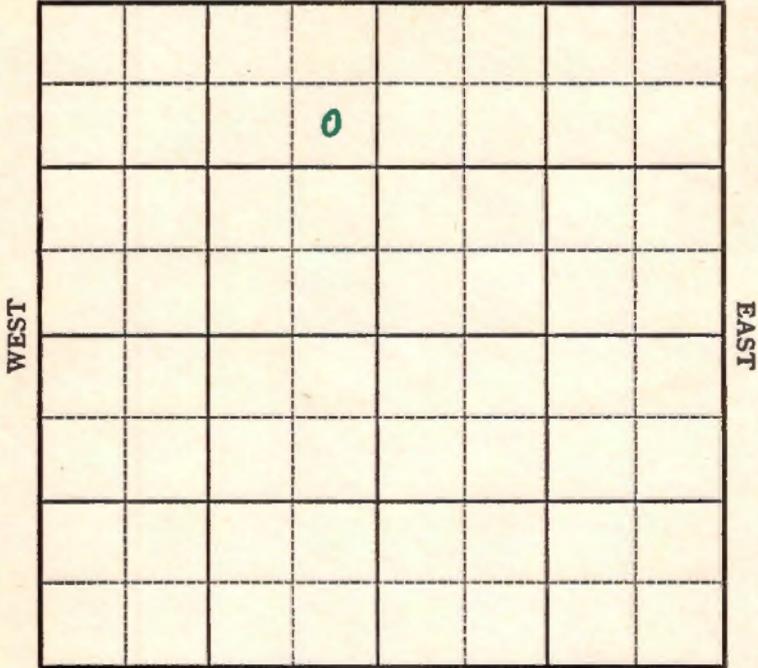

SOUTH


Sec. 13 Twp. 25 R. 13-W

Well No. #2 Geo. Russell Farm

Continental & Cities Service Company

(Leesburg)

NORTH

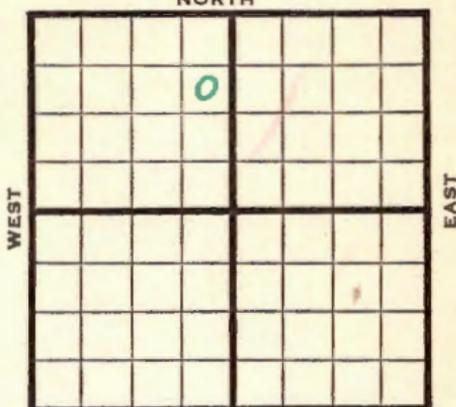

990 Ft. from N. Line

\_\_\_\_\_ Ft. from S. Line

330 Ft. from E. Line

\_\_\_\_\_ Ft. from W. Line

**Elev. 1915**

**1942** **REPORT**

7/1 Surface hole.  
7/8 10" - 280' Drlg. 2530'  
7/15 Drlg. 3706'  
7/22 Drlg. 4115'  
7/29 **Arb. 4114** 7" - 4115  
T.D. 4116 RUST.

8/5 **Arb. 4114'**  
7" - 4115  
T.D. 4125  
Echo Pot. 7312  
Max. 3000  
Gravity 38.

**COMPLETED**

1956

**O.W.W.O.**

2-1 7" @ 4115  
Whipstock @ 3975/25  
TD 4125  
5" @ 4119/25  
CO to 4100, 64/ 4059-76, acidfrac  
Comp. 25 bopd  
**S. 4062**  
**A. 4114**  
TD 4125'

**FIRST REPORT**

*f*  
**COMPLETED**

O.W.W.O.

OWWO

FORM 513 REV. SUNRAY

County Stafford Elev. 1915  
 Sec. 13 Twp. 25 Rge. 13W  
 Company Continental Oil etal.  
 Farm Name Geo. Russell No. 2

TOPS	DEPTH	LOG	DATUM	Loc. in Sec.
Anh.				SE NE NW
Tr.				1000' NL
Dg.				2310' WL
Bl.				Geol.
L.				Contr.
K.C.				Pool
B.K.C.				Leesburg
Ce.				FIRST REPORT
C.				
M.				FEB 1 '56
M.				
K.				COMPLETE
Mz.				
Me.				
V.				
S.	4062			
A.	4114			
R.				
PE.				
G.				
TD.	4125			

Date Comm. 7" @ 4115 whipstock @ 3975/25  
TD 4125 5" @ 4119/25 Co to 4100  
64/ 4059-76 acid-frac  
Comp. 25 bopd

Co.  
Lse.  
No.  
Sec.  
T.  
R.

Map No. 83 Sec. 13 Twp. 25 R. 13W

Well No. 2 Geo. Russell

Continental & Cities Company  
Service

# FIRST REPORT

Contractor

SE NE NW


## SECTION PLAT

990 Ft. from N. Line

\_\_\_\_\_ Ft. from S. Line

330 Ft. from E. Line

\_\_\_\_\_ Ft. from W. Line

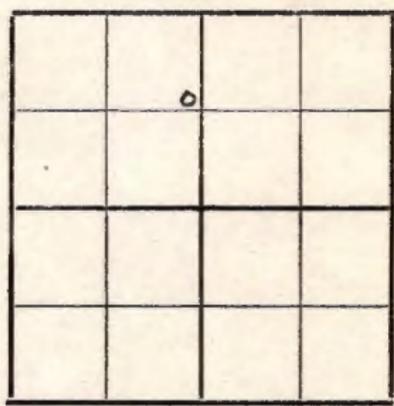

## LEESBURG POOL

### RECORD

Location \_\_\_\_\_

Cased \_\_\_\_\_ in., \_\_\_\_\_ ft.

Rig up \_\_\_\_\_

Sand \_\_\_\_\_

Drilling and Remarks:

Gas \_\_\_\_\_

Oil \_\_\_\_\_

Total Depth \_\_\_\_\_

Surface Hole ;

### PRODUCTION

1st 24 hrs. Nat. \_\_\_\_\_

1st 24 hrs. after shot \_\_\_\_\_

Gas \_\_\_\_\_ Cu. Ft.

Dry Hole \_\_\_\_\_

Abandoned \_\_\_\_\_

Date

JUL 1 1942

19

S. J. LEWIS

Scout

Stafford

KANSAS

Map No. 83 Sec. 13 Twp. 25 R. 13W

Well No. 2 Geo. Russell

Continental & Cities Company

Service

**COMPLETED**

Contractor

SE NE NW

SECTION PLAT

990 Ft. from N. Line

\_\_\_\_\_ Ft. from S. Line

330 Ft. from E. Line

\_\_\_\_\_ Ft. from W. Line

	o		

LEESBURG POOL

Location \_\_\_\_\_

Rig up \_\_\_\_\_

Drilling and Remarks:

*Ce & 4114*  
*7" @ 4115.*  
*Ech & P & 7312*  
*Max 3000*  
*380 Gr*

RECORD

Cased \_\_\_\_\_ in., \_\_\_\_\_ ft.

Sand \_\_\_\_\_

Gas \_\_\_\_\_

Oil \_\_\_\_\_

Total Depth 4125

PRODUCTION

1st 24 hrs. Nat. \_\_\_\_\_

1st 24 hrs. after shot \_\_\_\_\_

Gas \_\_\_\_\_ Cu. Ft.

Dry Hole \_\_\_\_\_

Abandoned \_\_\_\_\_

Date

AUG 5 1942 19

S. I. LEWIS Scout