

O.W.W.O.

Form 51—5M—11-38—Palace


Stafford

KANSAS

Section 13 Township 25 Range 13-W

Well No. #1 Geo. Russell

Company Continental et al

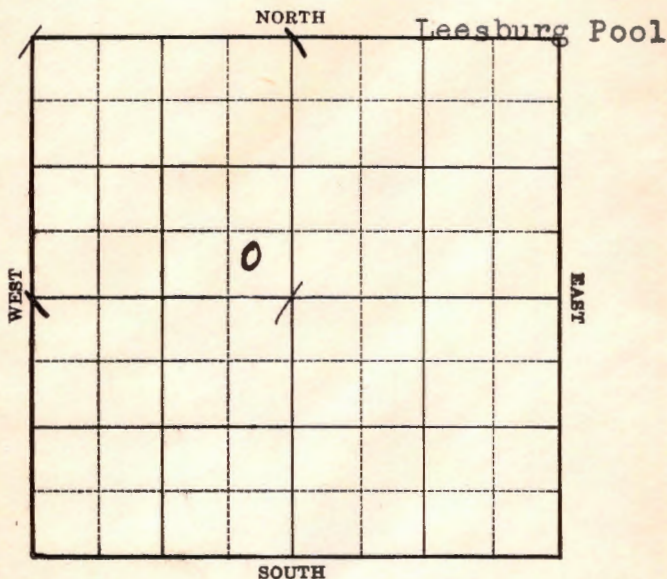

1939
4/26

7" - 4116'

Arb. 4115'

T. D. 4132'

Pump 930 bbls.

Potential 2791 bbls., Natural.

COMPLETED

O.W.W.O.

1951
4/4

Oil well TD 4095'

Lans 3565' Cóng 3880' Viola 3975'

Simp. 4060-85' Arb. 4115'

7" @ 4116' OTD 4121' SP 4095'

63/ 4060-84 S/ 68 BOPD

Comp. 65 BOPD


FIRST REPORT

COMPLETED

Stafford **KANSAS**Map No. 83 Sec. 13 Twp. 25 R. 13WWell No. 1 Geo. RussellContinental etal

Company

Contractor

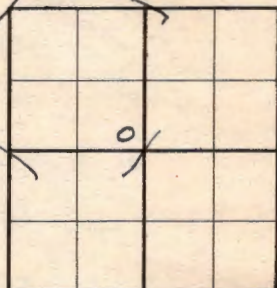FIRST REPORT**SE NW** Ft. from N. Line440 Ft. from S. Line440 Ft. from E. Line Ft. from W. Line**LEESBURG POOL****SECTION PLAT**Location XRig up

Drilling and Remarks:

RECORDCased in., ft.Sand Gas Oil Total Depth **PRODUCTION**1st 24 hrs. Nat. 1st 24 hrs. after shot Gas Cu. Ft.Dry Hole Abandoned

Date

MAR 8 - 193919H. D. Hatfield Scout

Stafford

KANSAS

Map No. 83 Sec. 13 Twp. 25 R. 13WWell No. 1 Geo. RussellContinental etal

Company

Contractor

COMPLETED

SECTION PLAT

SE NW

 Ft. from N. Line440 Ft. from S. Line440 Ft. from E. Line Ft. from W. Line

LEESBURG POOL

Location Rig up

Drilling and Remarks:

P-930

Pot 2791

Nat

RECORD

Cased 7 in., 4116 ft.Sand ARB 4115Gas Oil Total Depth 4132

PRODUCTION

1st 24 hrs. Nat. 1st 24 hrs. after shot Gas Cu. Ft.Dry Hole Abandoned

Date

APR 26 1939

19

H. D. Hatfield

Scout

County **Stafford** State **Kansas**Sec. **13** (Blk.) **25** (Sur.) **13W** Map No.Operator **Continental Oil**Well No. **1** Farm **Russell**Elev. **1918** Location **SE SE NW**

FIRST REPORT

0

COMPLETE

440 Ft. From **8** Line **NW****440** Ft. From **E** Line Quarter1st. Report **APR 4 1951**Completion **APR 4 1951**Remarks **OWWO.O.W.W.O.****Leesburg Pool**

Spudding Date

Drig. Data **Oil well TD 4095****Lane. 3565 Cong. 3880 Viola 3975****Simp. 4060-85 Arb. 4115 7" @ 4116****OTD 4121 SP 4095 63/ 4060-84****S/ 68 bopd Comp. 65 bopd**

J. E. TYRA