


Section 13 Township 25 Range 13-W

Well No. 1 M. Russell

Company Continental

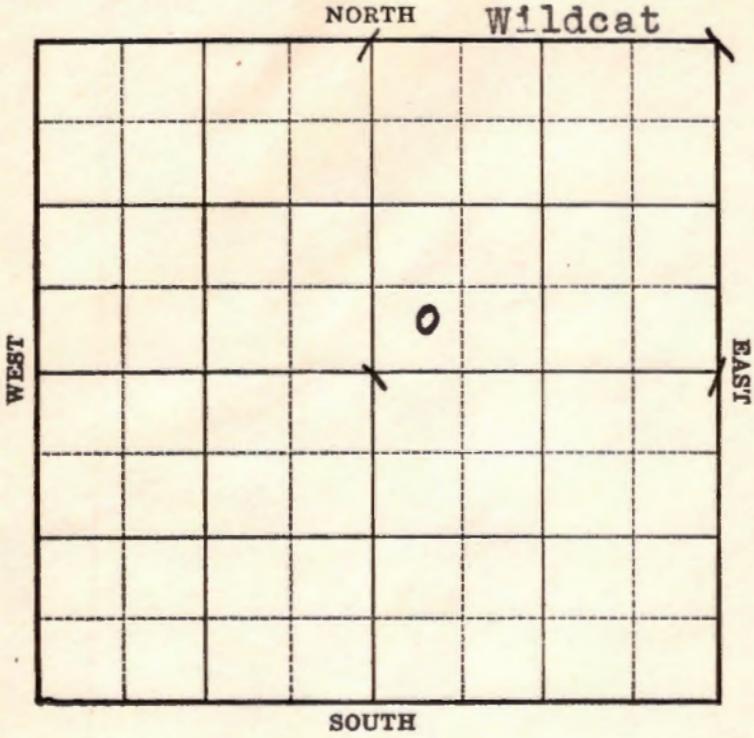

Sec. 13 Twp. 25 R. 13-W

Well No. #1 M. Russell Farm

Continental Company


(Wildcat)

         Ft. from N. Line

440 Ft. from S. Line

         Ft. from E. Line

440 Ft. from W. Line

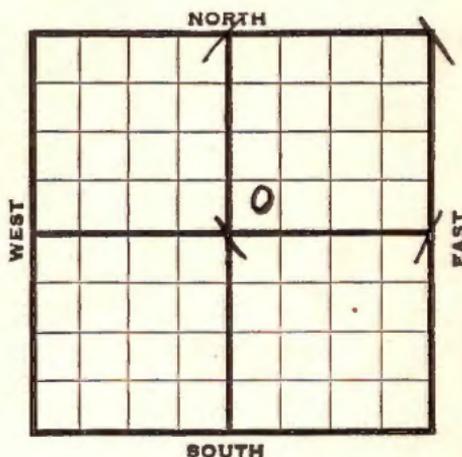

Elev. 1917

1939	REPORT
1/25	R.U.R.
2/3	10" - 442'. Anhy 735'.
	Drlg. 2012'.
2/10	Topeka <sup>3010</sup> <del>3065</del> '. Lans. <sup>3550</sup> <del>3580</del> '.
	Dlg. 3750'.
2/13	Simson <sup>3970</sup> <del>3975</del> '.
	Arbuckle <sup>4024</sup> <del>4025</del> , 2' of spotted
	saturation 4040-42' T.D.
	Running casing.
	This well is 126' higher than
	Cont. et al #1 Fair in the
	C N L SE of Sec. 12, and is 41'
	higher than their #1 McCune in
	the SW NE of Sec. 12.
	The new test is 1 mile south of
	these wells. (Letter from H.D.H

OVER

1939

2/17

Correction on tops:

Topeka 3040'. Land. 3550'.

Viola 3900' Simp. 3970'

Arb. 4024'. T. D. 4041'.

Show oil. 7" - 4027'. RUST.

2/21

Arb. 4024-41' T.D.

After cementing casing at 4027,  
they drilled out the plug and  
the hole filled 3900' with oil  
in 45 minutes and they are now  
trying to clean out a bridge.

(Letter from H.D.H.)

3/1--T.D. 4072 green shale

Have 3975' oil in hole (Tel)

3/10

T.D. 4075'

SD tanks.

3/15

7" - 4027'

Arb. 4024'

T. D. 4075'

Pump 948 bbls. 8 hours.

Potential 2843 bbls. natural.

No water.

Gravity 38.7 at 68.

COMPLETED

Map No. 82 Sec. 13 Twp. 25 R. 13W

Well No. 1 M. Russell

Continental Company

Contractor

**FIRST REPORT**

**SW NE**

\_\_\_\_\_ Ft. from N. Line

440 Ft. from S. Line

\_\_\_\_\_ Ft. from E. Line

440 Ft. from W. Line

**SECTION PLAT**


*Barnsdall  
Farm-out*

*Wildcat*

Location \_\_\_\_\_

Rig up \_\_\_\_\_

Drilling and Remarks:

**RUR**

**RECORD**

Cased \_\_\_\_\_ in., \_\_\_\_\_ ft.

Sand \_\_\_\_\_

Gas \_\_\_\_\_

Oil \_\_\_\_\_

Total Depth \_\_\_\_\_

**PRODUCTION**

1st 24 hrs. Nat. \_\_\_\_\_

1st 24 hrs. after shot \_\_\_\_\_

Gas \_\_\_\_\_ Cu. Ft.

Dry Hole \_\_\_\_\_

Abandoned \_\_\_\_\_

Date

JAN 25 1939

19

H. D. Hatfield Scout

Stafford

Map No. 83 Sec. 13 Twp. 25 R. 13W

Well No. 1 M. Russell

Continental Company

Contractor

**COMPLETED**

**SECTION PLAT**

SW NE

         Ft. from N. Line

440 Ft. from S. Line

         Ft. from E. Line

440 Ft. from W. Line

		0	

**LEESBURG POOL**

Location                                 

Rig up                                 

Drilling and Remarks:

*P- 948/8*

*Pot 2843 NAT.*

*No wtr*

*grau 38.7/68*

**RECORD**

Cased 7 in., 4027 ft.

Sand ARB 4024

Gas                                 

Oil                                 

Total Depth 4075

**PRODUCTION**

1st 24 hrs. Nat.                                 

1st 24 hrs. after shot                                 

Gas                                  Cu. Ft.

Dry Hole                                 

Abandoned                                 

Date

MAR 15 1939 19

H. D. Hatfield Scout

~~Pool~~ ~~Facet~~  
 Pool ~~X~~  
 Facet ~~26~~  
**O. W. P. B.**

S-513-B

County Stafford Elev. \_\_\_\_\_  
 Sec. 13 Twp. 25 Rge. 13W  
 Company Continental Oil Co.  
 Farm Name Maggie Russell No. 1

TOPS	DEPTH	LOG	DATUM
Anh.	<del>3010</del> <sup>735</sup>		
Tp.			
H.			
Tr.			
Dg.			
B.L.			
L.	3050		
K.C.			
B.K.C.			
Ce.			
C.			
M.			
M.			
K.			
Mz.			
Mq.			
V. Sd	3900		
S.	3970		
S.			
A.	4024		
R.			
Pf.			
G. OTD	4075		
<u>I.D.</u>			

Loc. in Sec. \_\_\_\_\_  
**App SW SW NE**  
 2200' fnl x  
 2200' fel  
**(O.W.P.B.)**  
 Geol. \_\_\_\_\_  
 Contr. \_\_\_\_\_  
**O. W. P. B.**  
 Pool \_\_\_\_\_  
**Leesburg**

AUG 8 1968  
**FIRST REPORT COMPLETE**

Date Comm. OLD INFO: Tops. 7" @ 4027.  
NEW INFO: CO 4075, PB 4012, 74" @ 4010 w/225,  
CO 4000, GRN log, perf 64/3944-3960 (Vi)  
1000A, Bld 10 go, nw, 12 hrs, frac 4 x 4, no  
rec. ld, CO 4000, PB 3850 perf 40/3750-60 (Lans  
2000A, fl 135 BO no wtr 3 1/2 hrs, Phy flo: 223  
BO & 20 BW 2 1/2 hrs (33.2° gravity) Lans 3750-60,  
TD 4075, PB 3850.

Co. \_\_\_\_\_  
 Lse. \_\_\_\_\_  
 No. \_\_\_\_\_  
 Sec. \_\_\_\_\_  
 T. \_\_\_\_\_  
 R. \_\_\_\_\_