


Stafford

KANSAS

SECTION 17 TOWNSHIP 25S RANGE 13W

WELL NO. #1 Lyons

COMPANY Musgrove Petroleum

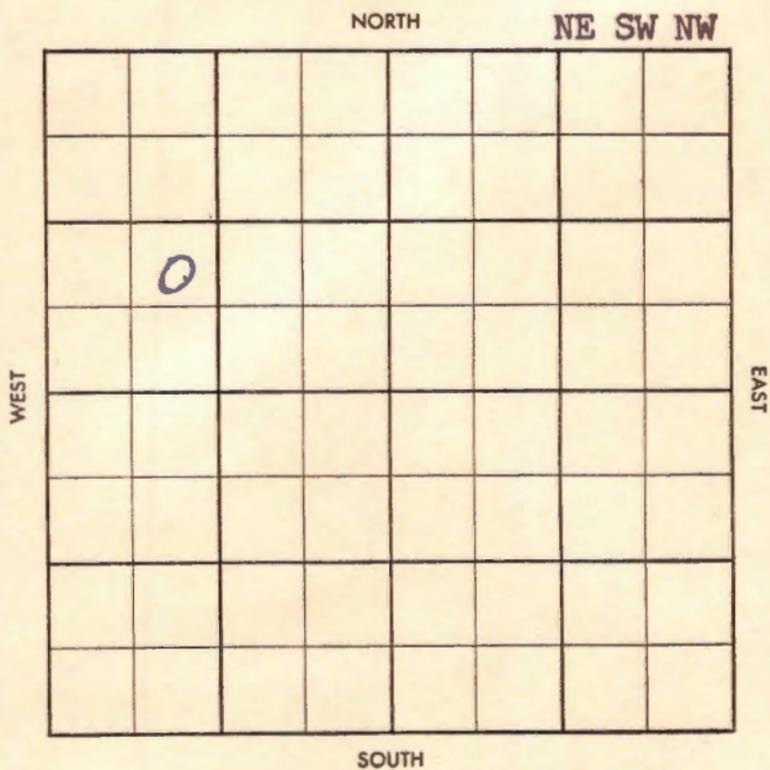

Twp. ~~X~~ Pool ~~X~~
 Co. ~~X~~ Facet ~~26~~

S-513-B

County Stafford Elev. _____
 Sec. 17 Twp. 25 Rge. 13W
 Company Musgrove Petroleum
 Farm Name Lyons No. 1

TOPS	DEPTH	LOG	DATUM
Anh.			
Tp.			
H.			
Tr.			
Dg.			
B.L.			
L.			
K.C.			
B.K.C.			
Ce.			
C.			
M.			
M.			
K.			
Mz.			
Mq.			
V.			
S.			
S.			
A.			
R.			
Pf.			
G.			
T.D.			

Loc. in Sec. NE SW NW
 Geol. _____
 Contr. Co. Tools #8
 Pool Kachelman



Date Comm. 3/21/58
8" @ 320 w/275, Drlg. 278

Co.
Lse.
No.
Sec.
T.
R.

② 5Ld+9/30 ph NW T6R

POP

P25/30pd NW

36°q

APR 23 '58

APR 30 '58

MAY 7 '58

POT P 21580 pd NW

34°q

alt 9271-80

17-25-13W

ne sw nw