


Section 17 Township 25 Range 13 W

Well No. # 1 Lyons

Company Elreco & Rock Island Ref. Co.

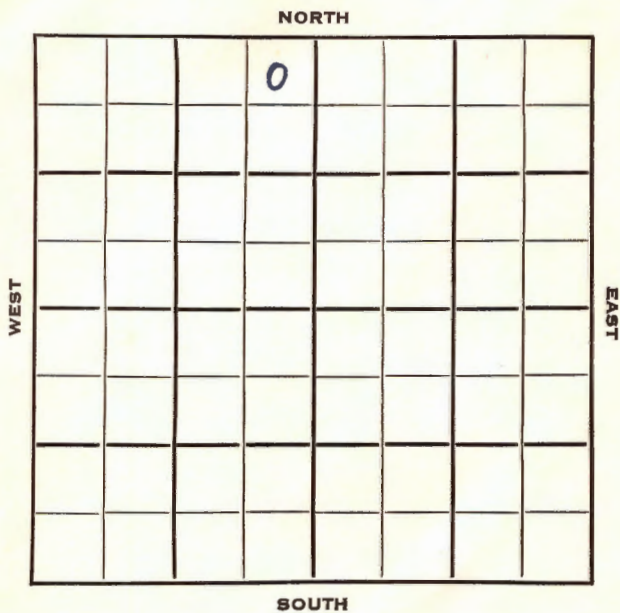

Sec. 17 Twp. 25 R. 13 W

Well No. # 1 Lyons Farm

Elreco & Rock Island Ref. Co. Company

Sterling Drlg. Contractor


Wildcat

330 Ft. from N. Line

_____ Ft. from S. Line

330 Ft. from E. Line

_____ Ft. from W. Line

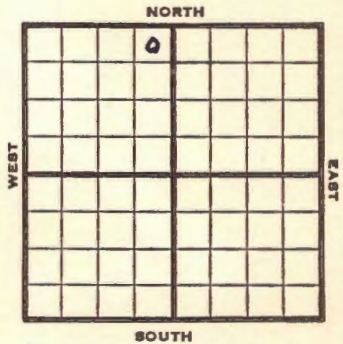

NE NE NW
Sunray - DHM

1953

Elev. 1953'

REPORT

6/24

RUR

7/1

8" @ 320 Anhy 830 Top 2980
Drlg. 3100'

7/8

Heeb 3510 Br li 3662 Lans 3686
DST 3938-71, 1 hr, 20' M
B KC 3982 Miss 4036
DST 4039-89, 1 hr, 210' SO & GCM
420# V 4098
DST 4100-4106, 1 hr, 25' M 645#
Drlg. 4215'

7/15

Spud 6-23-53

D&A

TD 4316

8" @ 320

Anhy 830, Top 2980, Heeb 3510, Br line
3662, Lans 3686

DST 3938-71, opn 1 hr., rec. 20' mud,
O#

B KC 3982, Miss 4036

DST 4039-89, opn 1 hr., rec. 210' so
& gcm, 420#

Viola 4098

DST 4100-06, opn 1 hr., rec. 25' mud,
645#

DST 4198-4223, opn 1 hr., rec. 35' mud,
555#

OVER

(Information Brought Forward)

1953

7/15

Simp 4230

DST 4252-82, opn 3/4 hrs., rec. 15'
mud, O#

Arb. 4292

TD 4316

D&A

ABANDONED

County **Stafford** State **Kansas**

Sec. **17** (Blk. Twp.) **25** (Sur. Rge.) **13W** Map No.

Operator **Elreco & Rock Island Ref. Co.**

Well No. **1** Farm **Lyons**

Elev. Location **NE NE NW**

		0			

FIRST REPORT

330 Ft. From **N** Line **NW**

330 Ft. From **E** Line Quarter

1st. Report **JUN 24 1953**

Completion

Remarks **Sunray - IHM**

Sterling Drlg. - Contr.

Spudding Date

Drlg. Data **Wildcat**

RUR

County Stafford State Kansas
 Sec. 17 (Blk. 25) (Sur. 13W) (Twp. 13W) Map No.
 Operator Elreco & Rock Island Ref. Co.
 Well No. 1 Farm Lyons
 Elev. 1953 Location NE NE NW



330 Ft. From N Line NW
330 Ft. From E Line Quarter
 1st. Report
 Completion JUL 15 1953
 Remarks Wildcat
Sterling - Contr.
 Spudding Date 6-23-53
 Drig. Data D &-A TD 4316

8" @ 320 Anhy 830 Top. 2980

Heeb. 3510 Br. lime 3662 Lans. 3686

DST 3938-71 open 1 hr. Rec. 20' mud

O# B KC 3982 Miss. 4036 DST 4039-89

open 1 hr. Rec. 210' so & gcm 420#

Viola 4098 DST 4100-06 open 1 hr.

Rec. 25' mud - 645# DST 4198-4223

open 1 hr. Rec. 35' mud 555#

Simp. 4230 DST 4252-82 open 3/4 hr.

Rec. 15' mud O# Arb. 4292 TD 4316

D. & A