


Section 17 Township 25 Range 13 W

Well No. #2 Lyons

Company Elreco

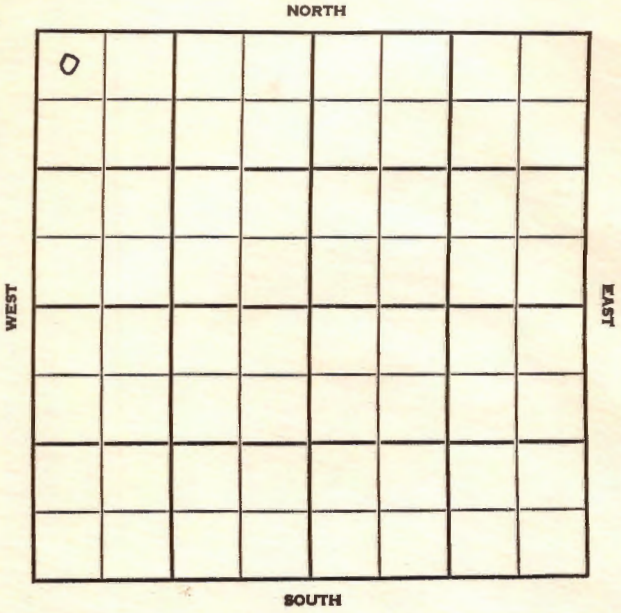

Stafford

KANSAS

SEC.	TWP.	R.
17	25	13W

WELL NO.

#2 Lyons

FARM

COMPANY

Elreco

CONTRACTOR

Prime Drlg
Kackelman

_____ Ft. from N. Line

_____ Ft. from S. Line

_____ Ft. from E. Line

_____ Ft. from W. Line

NW NW NW

NORTH

WEST

EAST

SOUTH

1955

ELEVATION
1958'

REPORT

9/21

Location

11-30

Comm. 10-5-55

8 5/8" @ 304/250

DST 3918-53 op 1/2 hr. rec. 15' mud. 0#

DST 4280-90 op 1 hr. rec. 1525' gas,

525' oil, 50' ocm, 10' mw, 930#

5 1/2" @ 4282/125

CO to 4290

S/ 1 2/3 boph, 500 A, 1000 A,

Perf 4270-75,

CO to # 4290

S/ 34.5 BO 54 BW 12 hr.,

S/ 40 BO, 25.8 BW, 12 hrs.,

FU 1350' oil, 350' wtr., 12 hrs.

P/ 42 BO 23, BW, 15 hrs.

P/ 57 BO, 34% wtr.,

Comp. 48 Bopd, 40% wtr.

Anh. 812

sd 4243

H. 3504

A. 4281

Tr. 3532

T.D. 4290'

Dg. 3546

BL. 3653

L. 3677

BKC 3949

M. 4036

K. 4047

V. # 4098

Sh. 4224

COMPLETED

~~ABANDONED~~

County Stafford Elev. 1958
 Sec. 17 Twp. 25 Rge. 13W
 Company Elreco
 Farm Name Lyons No. 2

TOPS	DEPTH	LOG	DATUM
Anh.	812		
Tp.			
H.	3504		1546
Tr.	3532		1574
Dg.	3546		1588
Bl.	3653		1695
L.	3677		1719
K.C.			
B.K.C.	3949		1991
Ce.			
C.			
M.	4036		2078
M.			
K.	4047		2089
Mz.			
Mq.			
V.	4098		2140
S.	4224		2266
S.	4245		2285
A	4281		2323
R.			
PE.			
G.			
T.D.	4290		

Loc. in Sec. NW NW NW
 Geol. _____
 Contr. _____
 Pool Prime
Kackelman
 COMPLETE

Date Comm. 10-5-55 NOV 30 1955
8 5/8" @ 304/250 DST 3918-53 open
1/2 hr. rec. 15' mud " 0#" DST/4280-90
open 1 hr. rec. 1525' gas 25' oil
50' ocm 10' mw 930# 5 1/2" @ 4282/125
CO to 4290 S/ 1 2/3 boph 500 A
1000 A perf. 4270-75 CO to 4290
S/ 34.5 bo 54 bw 12 hr. S/ 40 bo
25.8 bw 12 hr. FW 1350' oil 350' wtr.
12 hr.

Co.
 Lse.
 No.
 Sec.
 T.
 R.

P/ 42 bo 23 bw 15 hr. P/ 57 bo
34% wtr. Comp. 48 bopd 40% wtr.

Scout Cards *ng*
Land Small Map
Land Wall Map
Tracings
France Map
Pierce Map
Misc.

DEC 8 1955