


Section 18 Township 25 Range 13W

Well No. 2 Curtis

Company N C R A

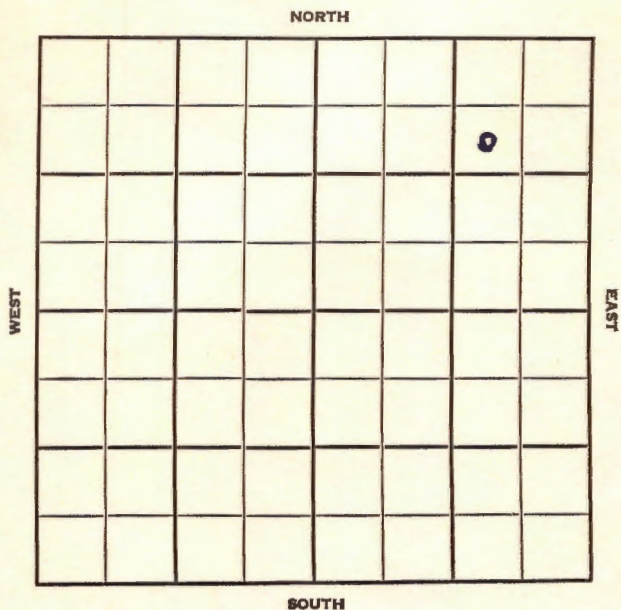

Stafford **KANSAS**


SEC.	TWP.	R.
18	25	13 W

WELL NO. # 2 **Curtis** FARM

COMPANY **N C R A**

CONTRACTOR **Armer Kachelman Pool**

990 _____ Ft. from N. Line
 _____ Ft. from S. Line
 990 _____ Ft. from E. Line
 _____ Ft. from W. Line

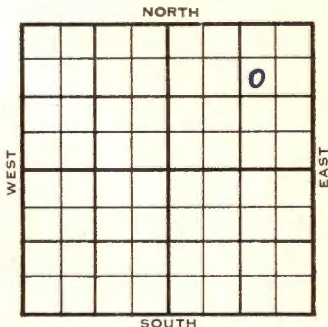

SW NE NE

	ELEVATION	REPORT
1955	1959'	
2/23		Spud 2-21-55 8" @ 280' Drlg.
3/9		Spud 2-21-55 - D&A TD 4325' 8" @ 280' Anhy 830', Heeb. 3512', Tor 3530', Br lime 3656', Lans 3682' DST 3720-17', opn 1 hr., rec. 60' gas 30' gcm, 0# DST 3811-27, opn 1 hr., rec. 260' gas, 40' o&gcm, 3' wtr, 400# DST 3755-75, opn 1 hr., rec. 30' wm 1260# DST 3878-3902', opn 1 hr., rec. 295' gas, 65' so&gcm, 100# DST 3940-54, opn 1 hr., rec. 5' mud, 0# Cong. 4036', Miss. 4043', Viola 4108', DST 4109-26, opn 1 hr., rec. 10' mud, 0# Arb. 4301' TD 4325' D&A

ABANDONED

