

KANSAS

Stafford

FORM 51 5M 4-41 PETROL


O.W.W.O.

Section 18 Township 25 Range 13-W

Well No. #1 Curtis

NCRA

Company ~~Elbar Oil~~

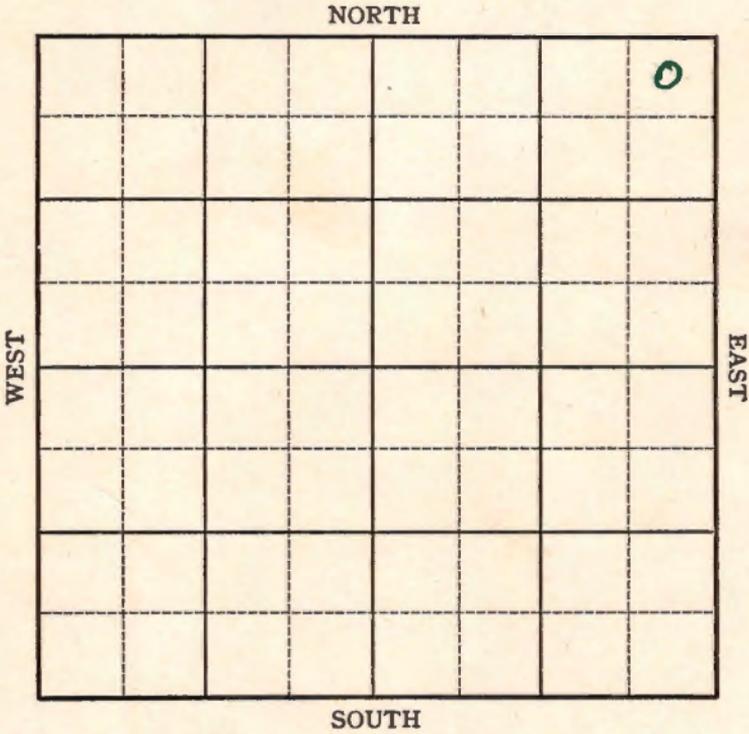

O.W.W.O.

Sec. 18 Twp. 25 R. 13-W

Well No. #1 Curtis Farm

~~Elbar Oil~~ NCKA Company

(Wildcat)

330 Ft. from N. Line


Ft. from S. Line

330 Ft. from E. Line

Ft. from W. Line

NE NE NE

Elev. 1961

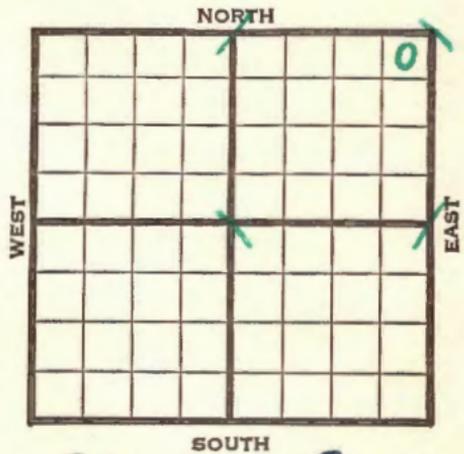

GARVEY - CONTR.

1941

REPORT

7/1 Mov. in rotary Mat'l.

7/10 Rotary.

7/17 8" - 400' Drlg. 2400'

7/24 Topeka 3110 Drlg. 3340'

7/31 Lansing 3680' Viola 4802'

Arb 4270' Coring.

8/6 Arb 4290'

TD 4325'

No Shows

ABANDONED

O.W.W.O.

1954

11/17 KC 3685', Miss 4025', Kh. 4045',  
Viola 4162', Simp. 4228', Arb. 4288'  
OTD 4325'

CO

OVER

1955  
1/12

Oil Well

TD 4327'

KC 3685', Miss 4025', Kh. 4045',  
Viola 4102', Simp. 4228', Arb. 4288'

ØTD 4325'

5" @ 4327'

18/4251-54 wtr., frac

SP 4241'

Petro-frac

42/4231-38, 250A

Petro-frac

S/8.35 bo 3 hrs.

PB 4043'

1/4032, 1/4044,

S/10 bo 10 hrs.

Petro-frac

SP 3972'

18/3946-49, 21 go 2 hrs., 500A

S/85 bf 30% wtr. 1½ hrs.

S/31 bo 2½ hrs.

P/116 bo 2% wtr.

Comp. 135 bopd 2% wtr.

**COMPLETED**

KANSAS

Map No. 83 Sec. 18 Twp. 25 R. 13W

Well No. 1 Curtis

Elbar Oil Company

ABANDONED Contractor

SECTION PLAT

NE/C

330 Ft. from N. Line

\_\_\_\_\_ Ft. from S. Line

330 Ft. from E. Line

\_\_\_\_\_ Ft. from W. Line

			0

WILDCAT

Location \_\_\_\_\_

Rig up \_\_\_\_\_

Drilling and Remarks:

*Ac 4290*

*Noe howe*

RECORD

Cased \_\_\_\_\_ in., \_\_\_\_\_ ft.

Sand \_\_\_\_\_

Gas \_\_\_\_\_

Oil \_\_\_\_\_

Total Depth 4925

PRODUCTION

1st 24 hrs. Nat. \_\_\_\_\_

1st 24 hrs. after shot \_\_\_\_\_

Gas \_\_\_\_\_ Cu. Ft.

Dry Hole \_\_\_\_\_

Abandoned \_\_\_\_\_

Date

AUG 6 1941 19

S. J. LEWIS Scout

Map No. 83 Sec. 18 Twp. 25 R. 13WWell No. 1 CurtisElbar Oil

Company

~~FIRST REPORT~~

Contractor

NE/C

330 Ft. from N. Line


Ft. from S. Line

330 Ft. from E. Line

Ft. from W. Line

WILDCAT

## SECTION PLAT

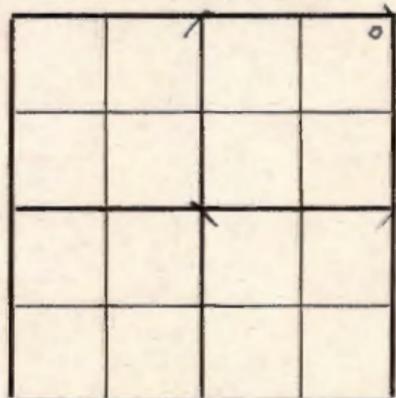

Location \_\_\_\_\_

Rig up \_\_\_\_\_

Drilling and Remarks:

Moving in Rotary  
Material

## RECORD

Cased \_\_\_\_\_ in., \_\_\_\_\_ ft.

Sand \_\_\_\_\_

Gas \_\_\_\_\_

Oil \_\_\_\_\_

Total Depth \_\_\_\_\_

## PRODUCTION

1st 24 hrs. Nat. \_\_\_\_\_

1st 24 hrs. after shot \_\_\_\_\_

Gas \_\_\_\_\_ Cu. Ft.

Dry Hole \_\_\_\_\_

Abandoned \_\_\_\_\_

Date

JUL 1 1941

19

S. J. LEWIS Scout



