

Stafford


KANSAS

SECTION 23 TOWNSHIP 25 RANGE 13 W

WELL NO. #1 Harrison

COMPANY N C R A & Welch & Olsson

NORTH

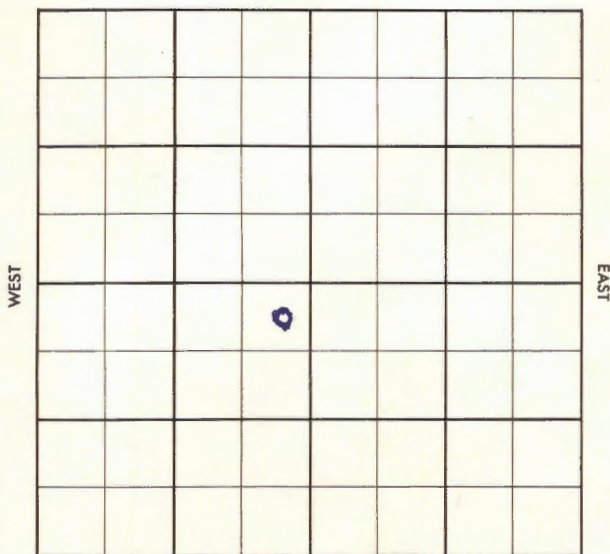

SOUTH

Stafford

KANSAS

SEC. 23	TWP. 25	R. 13W
------------	------------	-----------

WELL NO.

#1 Harrison

FARM

COMPANY

NCRA & Welch & Olsson

CONTRACTOR

Welch & Olsson


WILDCAT

Ft. from N. Line

Ft. from S. Line

Ft. from E. Line

Ft. from W. Line

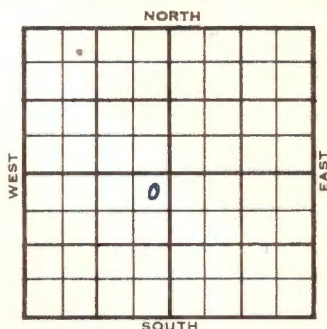

NE NE SW

	ELEVATION	REPORT
1956	1928	
3-7	Comm. 2-29-56 8" @ 235/175 Drlg. 3285 Anh. 770	
3-14	DST 4216-35 op 1 hr., SI 45 min, rec. 120' gas, 75' sgcm, 90' msw, 109# DST 4239-49, op 1½ hr. rec. 55' gcm, 60' msw, 1180# D & A Anh. 770 H. 3498 Tr. 3516 Dg. 3538 BL 3648 L. 3672 BKC 3951 Marm 3974 Sh. Cong. 4058 Chty Cong 4084 V. 4153 S. 4217 A 4287 TD 4312	

ABANDONED

County **Stafford** Elev. _____
 Sec. **23** Twp. **25** Rge. **13W**
 Company **N C R A & Welch & Olsson**
 Farm Name **Harrison** No. **1**

TOPS	DEPTH	LOG	DATUM	Loc. in Sec.
Anh.	770			NE NE SW
T.P.				
H.				
Tr.				
Dg.				
BL.				
L.				Geol. _____
K.C.				Contr. _____
B.K.C.				Welch & Olsson
Ce.				Pool _____
C.				Wildcat
M.				
M.				
K.				
Mz.				
Mq.				
V.				
S.				
S.				
A.				
R.				
PE.				
G.				
TD.				

FIRST REPORT
 MAR 7 '58

Date Comm. **2-29-56**
8" @ 235/175 drlg. **3285**

26

County Stafford Elev. 1928
 Sec. 23 Twp. 25 Rge. 13W
 Company N C R A & Welch & Olsson
 Farm Name Harrison No. 1

TOPS	DEPTH	LOG	DATUM	Loc. in Sec.
Anh.	770			NE NE SW
Tp.				
H.	3498		1570	
Tr.	3576		1588	
Dg.	3538		1610	
BL.	3648		1720	
L.	3672		1744	Geol.
K.C.				
B.K.C.	3951		2023	Contr.
Ce.				Welch & Olsson
C.				
M. <i>grm</i>	3974		2046	
M. <i>Sh. Cong</i>	4058		2130	Pool
K. <i>Cherty Cong</i>	4084		2156	Leiss
Mz.				
Me.				
V.	4153		2225	
S.	4217		2289	
S.				
A.	4287		2357	
R.				
Pe.				
G.				
TD.	4312			

Date Comm. 2-29-56

MAR 14 1956

8" @ 235/175 DST 4216-35 open 1 hr.

SI 45 min. rec. 120' gas 75' sgcm

90' msw 109# DST 4239-49 open 1½ hr.

rec. 55' gcm 60' msw 1180#

D & A