

Stafford


KANSAS

SECTION 23 TOWNSHIP 25 RANGE 13W

WELL NO. #2 Leiss

COMPANY Welch & Olsson & Sunray Mid-Continent

NORTH

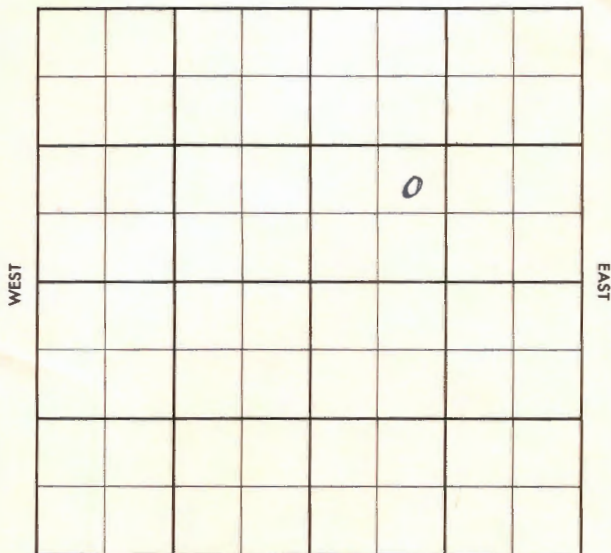

SOUTH

HOT FILE Stafford **KANSAS**
SEC. 23 TWP. 25 S R. 13 W

WELL NO.

2 Leiss

FARM

COMPANY

Welch & Olson (DEVELOPMENT-OB^{OC})

CONTRACTOR

& SDX

Co. tools


Leiss Field

_____ FT. FROM N. LINE

990 _____ FT. FROM S. LINE

_____ FT. FROM E. LINE

990 _____ FT. FROM W. LINE

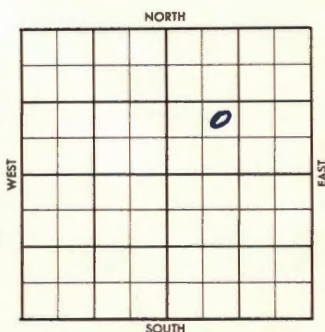

of NE/4
NE SW NE

ELEVATION

REPORT

1945

9/10

4300' Simpson-Arbuckle Test

Spudded 9-6-56

8-5/8" @ 240'

TD 240' WOC

(DR#176)

9/11

Drlg. 2850'

9/12

TD 2850'. NR

9/13

Drlg. 3305'

(FR. Ticket)

9/14

Drlg. 3610'

9/17

TD 3610' NR

9/18

TD 3610' NR

9/19

Drlg. 4224'

TD 4224'. Plugged & Abandoned (DR#183)

1923 DF

County Stafford Elev. 1926 RB
 Sec. 23 Twp. 25 Rge. 13W
 Company Welch & Olsson & Sunray Mid-Cont.
 Leiss No. 2

	DEPTH	LOG	DATUM	Loc. in Sec.
				NE SW NE
H.	3473	3473		
Tr.	3489	3478		
Dg.	3514	3513		
BL.	3621	3622		
L.	3648	3648		
K.C.				Geol.
BKC.	3916	3918		Contr.
Ce.	Marm 3939			Co. tools
C.g.	sh 4027			Pool
M.	cg chert 4056	4038		Leiss
M.				
K.				
Mz.				
Ma.				
V.	4116	4097		
S.	sh 4185	4187		
S.	sd 4193	4192-4217		
A.				
R.				
Pe.				
G.				
TD.	4250			

SEP 26 '56

0

ABANDONED

Date Comm.

82 @ 20/200 drlc. 3305 SEP 19 '56 Hb 3473

Tr 3489 Dg 3514 BL 3621 Lsg 3648
 BKC 3916 Marm 3939 Dst 3914-60
 op 1hr rec 90' Md BHP 1400# BKC
 3916 Marm 3939 cg sh 4027 cg chert
 4056 Viola 4116 sp sh 4185 sp sd
 4193 crd 4165-4200 Full rec. sh & sd
 sd had some stain low permeability crd
 4200-23 Full rec. Fair permeability

DST 4184-4225 or 1 hr see 15'

ID Md FP 0 BHP 1000 ID 4235

SEP 26 '58

X RTD 4250

D&A

23-25-13

ne sw ne

NO

FORM 513 SUNRAY

County Stafford Elev. _____
 Sec. 23 Twp. 25 Rge. 13W
 Company Welch & Olsson & Sunray Mid-Cont.
 Farm Name Leiss No. 2

TOPS	DEPTH	LOG	DATUM	Loc. in Sec.
Anh.	761			NE SW NE
Tr.				
Dg.				
Bl.				
L.				Geol.
K.C.				Contr.
B.K.C.				Co. tools
Ce.				Pool
C.				Leiss
M.				
M.				
K.				
Mz.				
Me.				
V.				
S.				
S.				
A.				
R.				
Pe.				
G.				
T.D.				

SEP 12 '66

0

FIRST REPORT

Date Comm.

82 @ 240/200 drlg. 3305

3305