

Stafford

KANSAS

DX 78-1

23

25


13W

Section _____ Township _____ Range _____

Well No. #2 McCandless

Company Nate Appleman

NORTH

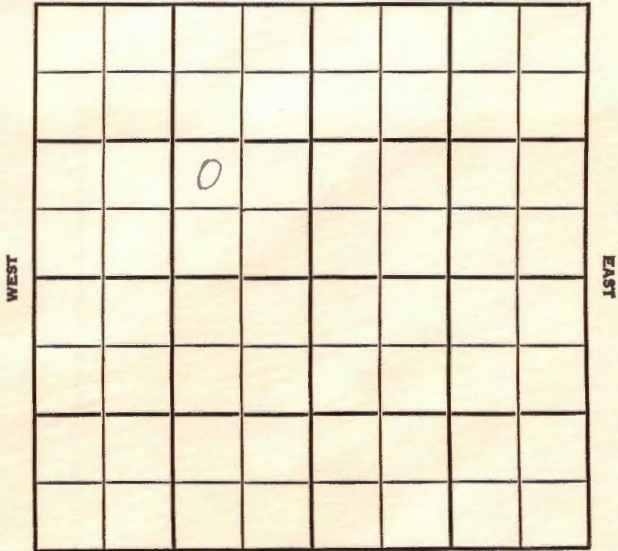

SOUTH

County Stafford Elev. _____
 Sec. 23 Twp. 25 Rge. 13W
 Company Nate Appleman
 Farm Name McCandless No. 2

TOPS	DEPTH	LOG	DATUM	Loc. in Sec.
Anh.				NW SE NW
Tr.				
Dg.				
Bl.				
L.				Geol.
K.C.				Contr.
B.K.C.				Welch-Olsson
Ce.				Pool
C.				Leiss
M.				
M.				
K.				
Mz.				
Mq.				
V.				
S.				
S.				
A.				
R.				
PE.				
G.				
T.D.				

	NOV 7 1956	
	0	
	SDX- 1/4 mi	
	FIRST REPORT	

Date Comm. 10-3-56
8" @ 252/200 drlg. 1950

NOV 7 1956

R.G.

13

County Stafford Elev. 1926 KB
 Sec. 23 Twp. 25 Rge. 13W
 Company Nate Appelman
 Name McLandless No. 2

OPS	DEPTH	LOG	DATUM	Loc. in Sec.
				NW SE NW
Ip.				
H.	3476			
Tr.				
Dg.				
Bl.	3629			
L.	3656			Geol.
K.C.				Contr.
B.K.C.	3927			Welch-Olsson
Ce.				Pool
C. <u>Marm</u>	3949			Leiss
M. <u>ag chert</u>	4057			ABANDONE NOV 23 '56 1/4 mi 4
M.	4067			
K.				
Mz.				
Me.				
V. <u>cherty</u>	4127			
S. <u>lilc cryst</u>	4173			
S.	4212			
A.				
R.				
Pe.				
G.				
TD.	4226			

Date Comm. 10-3-56

8" @ 252/200 drlg. 1950 NOV 13 '56

418/ NOV 21 '56 DST 4212-16 1hr
15' Mud No Press DST 4215-19
cr 1hr 60' MSW (VSSO) 1040/20"

D.E.A.