



Section 36 Township 25 Range 13W
 Well No. 2 Walters
 Company Armer Drlg. & Phillips Petr.

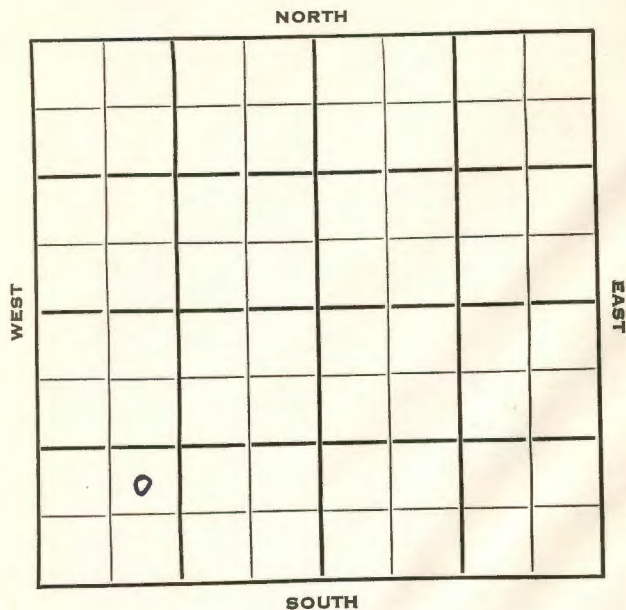

SEC. 36 TWP. 25 R. 13W ✓
 WELL NO. 2 Walters FARM
 COMPANY Armer Drlg. & Phillips Petr.
 CONTRACTOR Armer

Rose Valley Pool

990 Ft. from N. Line
990 Ft. from S. Line
990 Ft. from E. Line
990 Ft. from W. Line

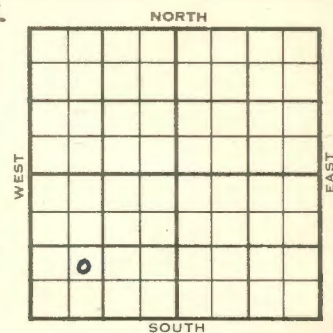

NE SW SW

	ELEVATION	REPORT
1954	1907'	
2/10	Spud 2-6-54 8" @ 270'	
2/17	Drlg. 1815'	
	Heeb 3489', Tor 3503', Doug 3529'	
	Br. L. 3648', Lans 3667'	
	DST 3818'-31'	
2/24	1 hr 10' SO&GCM, 110' gas, 152#	
	Miss 4076', Kh 4120', V 4137'	
	DST 4133'-50' 1 hr, 60' O&GCM 180' M	
	& gco 1132#	
	DST 4232'-48' 1 hr, 90' SOCM & W 1103#	
	Simp sho 4219', Simp sd 4231' Arb 4314'	
	RTD 4345'	
	Schl	
	5" @ 4305'	
3/24	Spud 2-6-54	
	Oil Well	
	TD 4345'	
	8" @ 270'	
	Heeb 3489', Tor 3503', Doug 3529'	
	Br. Lime 3648', Lans 3667'	
	DST 3818'-31' opn 1 hr, rec 10' so & g	
	110' gas, 152#	
	Miss 4076', Kh. 4120', Viola 4137'	

1954

Information brought forward.

3/24 DST 4133'-50' opn 1 hr, rec 60' o &
gcm, 180' mud & gco, 1132#
DST 4232'-48' opn 1 hr, rec 90' socm
& wtr.
1103# Simp Sh 4219', Simp Sd. 4231'
Arb 4314'
TD 4345'
5" @ 4305'
CO to 4283'
42/ 4236-50 Wtr. PB 4170'
52/ 5137-50 12 goph 2 hr.
500 A
S/ 1 boph 30% Wtr.
PB 3846'
24/ 3822-28 500 A S/ 7 bfph
90% Wtr. 12 hr.
sq 3822-28 CO to 4170
sdfrac
S/ 7 bfph 50% Wtr.
Comp 45 bopd 20% Wtr.

COMPLETED

Drilg. Data	Oil well	TD 4345
8" @ 270	Heeb. 3489	Tor. 3503
Doug. 3529	Br. lime 3648	Lans. 3667
DST 3818-31	open 1 hr.	Rec. 10' so & gcm
110' gas	152#	Miss. 4076 Kh. 4120
Viola 4137	DST 4133-50	open 1 hr.
Rec. 60' o & gcm	180' mud & geo	1132#
DST 4232-48	open 1 hr.	Rec. 90' socm &
wtr.	1103#	Simp. sh. 4219 Simp. sd.
4231	Arb. 4314	TD 4345 5" @ 4305
CO to 4283	42/ 4236-50	wtr. PB 4170
52/ 4137-50	12 goph	2 hr. 500 A
S/ 1 boph	30% wtr.	PB 3846 24/ 3822-28
500 A	S/ 7 bfph	90% wtr. 12 hr.
sq 3822-28	CO to 4170	sd-frac

J. G. McGEHEE

Orig. Data

S/ 7 bfph 50% wtr.

Comp. 45 bopd 20% wtr.

MAP 30-154

