


Map No. KANSAS Sec. 25 Twp. 4 R. 13W
 Well No. 1-Cornwell Farm Atlantic & Phillippe Company

NORTH

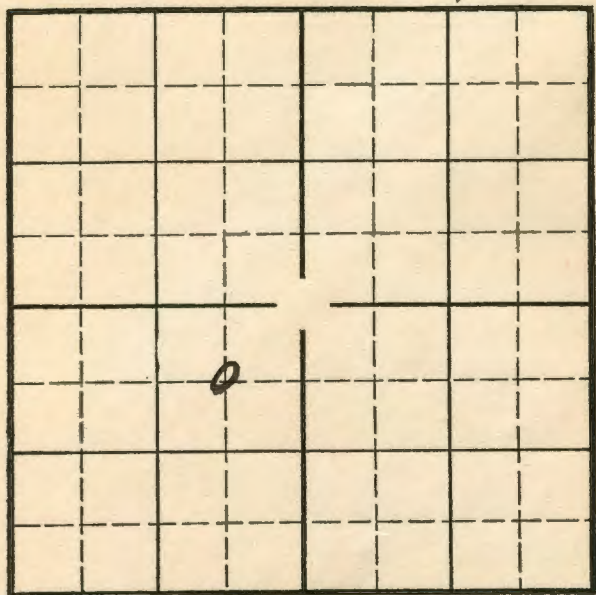

SOUTH


Location _____ Rig Up _____
 Drilling Remarks _____ Drilling Remarks _____

RECORD	PRODUCTION
Cased _____ in. _____ ft.	1st 24 hrs. Nat. _____
Sand _____	1st 24 hrs. after shot _____
Gas _____	Gas _____ cu. ft. _____
Oil _____	Dry Hole _____
Total Depth _____	Abandoned _____

Map No. KANSAS Sec. 4 Twp. 25 R. 13W
 Well No. 1-Cornwell Farm Atlantic & Phillippe Company

NORTH

660 Ft. from N. Line
 _____ Ft. from S. Line
660 Ft. from E. Line
 _____ Ft. from W. Line

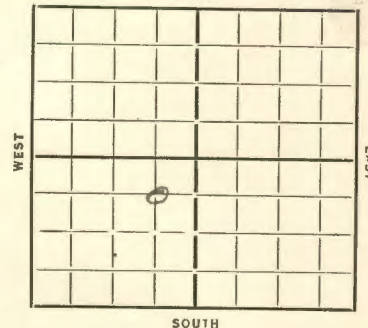

SOUTH

Date 1935 1942 LTS REPORT
7/31 Rotary Rig
8/8 Rig
8/15 12" 240 WOC.
8/22 dly 2015
8/29 " 3080
9/6 Lancing 3678
 Grind 3702
10/3 dly 4078 TV 3982
10/10 4072-82 40 Coring
10/30 Simpson 4194
 + 4270
 D & A.

ABANDONED

Map No. 83 Sec. 4 Twp. 25 R. 13W

Well No. 1 - Cornwell

Atlantic + Phillips Company

FIRST REPORTS

Contractor

SECTION PLAT

660 Ft. from N. Line

Ft. from S. Line

660 Ft. from E. Line

Ft. from W. Line

	0		

Location

Rig up

Drilling and Remarks:

Rat Rig

RECORD

Cased in, ft.

Sand

Gas

Oil

Total Depth

PRODUCTION

1st 24 hrs. Nat.

1st 24 hrs. after shot

Gas Cu. Ft.

Dry Hole

Abandoned

Date

7-31-25

192

Scout

Map No. 83 Sec. 4 Twp. 25 R. 13W

Well No. 1 - Cornwell

Atlantic + Phillips Company

Contractor

ABANDONED

SECTION PLAT

660 Ft. from N. Line

Ft. from S. Line

660 Ft. from E. Line

Ft. from W. Line

	0		

Location

Rig up

Drilling and Remarks:

NOT A

RECORD

Cased in, ft.

Sand Sampson 4194

Gas

Oil

Total Depth 4270

PRODUCTION

1st 24 hrs. Nat.

1st 24 hrs. after shot

Gas Cu. Ft.

Dry Hole

Abandoned

Date

10-30-35

192

Scout

ORVAL MANN SCHRECK